

FOR CONTRACT NO.: 07-258934

INFORMATION HANDOUT

PERMITS

CITY OF PASADENA (SAMPLE PERMIT)

MATERIALS INFORMATION

HAZARDOUS WASTE SITE INVESTIGATION, DATED MAY 27, 2011

GEOTECHNICAL REVIEW AND RECOMMENDATION, DATED FEB 2, 2012

AS-BUILTS

AS-BUILT ELECTRICAL PLANS

ROUTE: 07-LA-210-R15.0/R36.0

DEPARTMENT OF PUBLIC WORKS

CITY OF PASADENA

NO 49351 DL

Public Improvement Permit

Orig. - Customer

CITY HALL
100 N. GARFIELD AVE., N140
(626) 744-4195

Date August 24, 2011

THIS CERTIFIES, that California Dept of Transportation (Sujaya Kalainesan)

Address 100 S Main St Phone 213 786 1684

City LA State CA Zip

is hereby granted permission to construct (5) drive approaches (4) on Maple St and (1) on Corson St per Cal Trans Standards Contractor to apply for permit prior to work Traffic control per Cal Trans standards this permit is temporary for bidding purposes official permit shall be issued after contract has been awarded to contractor for Cal Trans

at Various

per Chapter 12.24 of the Pasadena Municipal Code, as amended, and in accordance with the "Standard Specifications For Public Works Construction", latest edition, and any special provisions of the Department of Public Works.

Permit Expires on:

August 24, 2012

Inspection MUST BE requested ONE DAY in advance.

Daniel A. Rix, City Engineer

By: 

AS

VOID UNLESS VALIDATED BY CASHIER

FEES	
Processing	\$ 0.00
Inspection	\$ 0.00
Rent	\$ 0.00
Other	\$ 0.00
Penalty	\$ 0.00
Total Fees	\$ 0.00
DEPOSITS	
Paving	\$ 0.00
Street Tree	\$ 0.00
Other	\$ 0.00
Total Deposits	\$ 0.00
PAY CASHIER	\$ 0.00

A VALIDATED COPY OF THIS PERMIT MUST BE KEPT AT THE JOB SITE AT ALL TIMES.

Copy

Memorandum

To: Sujaya Kalainesan, P.E.
Project Engineer

Date: May 27, 2011
File: LA-210 PM 0.0/36.0
LA River TMDLs Unit
EA: 258931 (0700000481)

From: **DEPARTMENT OF TRANSPORTATION**
Office of Environmental Engineering & Corridor Studies (OEECS)
Hazardous Waste Branch, North Region

Subject: Preliminary Hazardous Waste Site Investigation for 21 Proposed BMP Locations

This is in response to your memorandum dated September 08, 2010 requesting to provide hazardous waste assessment for the LA River Metal TMDLs project to attain water quality standards for storm-water discharged from the State's drainage system to the Los Angeles River. The work on this project will include construction of media filters, infiltration basins/tranches and/or bio-filtration swales. There may be a need for reconstructing the existing drainage system at the project locations to install devices, and the devices are to be constructed outside the traveled way and within the State Right of Way. Twenty-one (21) locations for the placement of devices have been identified based on the recommendation of the Corridor Storm-water Management Study for Route 210. There are no base maps available for the proposed locations. Conceptual plans indicating the proposed locations of the devices are provided to our Branch.

Previous Hazardous Waste Assessment

A hazardous waste assessment for 10 locations (Site Nos. 83, 107, 115, 121, 129, 138, 142, 144, 147, and 150) was conducted in March 2010 by CH2M HILL. Site No. 107 has been removed from the proposed location per project engineer's request. The Environmental Prescreening Report prepared by CH2M HILL presented soil sample test data for California Code of Regulations (CCR) Title 22 heavy metals, soluble lead, total petroleum hydrocarbons (TPHs) as gasoline and diesel, pH, volatile organic volatile compounds (VOCs), and semi-volatile organic compounds (SVOCs). For each location, four (4) soil samples from each of the two (2) borings were collected at different depths (1 foot, 4 feet, 5 feet and 7 feet or 10 feet) for analysis. No surface samples were collected and analyzed. The data was not adequate to classify the soil appropriately, and other 12 locations did not have any soil analytical results. A Task Order (TO) to conduct hazardous waste site investigation for all 21 proposed locations (see attached Table 1 – Proposed BMP Sites) has been initiated by our branch for proper classification of the soils.

Hazardous Waste Site Assessment

The hazardous waste branch has initiated a TO to conduct Site Investigation (SI) for Aerially Deposited Lead (ADL), CCR Title 22 heavy metals, pH, TPHs, VOCs, and SVOCs. The SI is being performed by Geocon Consultants, Inc., and the final hazardous waste SI report is expected to be completed by June 03, 2011. Per your request, we are providing preliminary hazardous waste assessment based upon the Draft SI report. Two (2) copies of the final hazardous waste SI report will be provided to your office after it becomes available.

Aerially Deposited Lead (ADL)

Forty-two borings (two for each location) and three (3) to five (5) samples from each location were collected and analyzed. The summary of ADL test results for these 21 proposed locations is presented in Table 2. The following are detail information for each location.

Location Nos. 1, 3, 4, 5, 6, 8, 9, 11, 12, 15, 18, 19, and 21 (13 Locations)

None of the samples collected at these 13 locations exhibits total lead and soluble lead levels higher than 1,000 mg/kg and 5.0 mg/liter, respectively. All excavated soil from these locations would be classified as non-hazardous waste with respect to lead content.

Location Nos. 2, 10, 17, and 20 (4 locations)

Excavated soils from the surface to a depth of 0.5 foot would be considered as California hazardous waste (Caltrans Type Y-1 or Z-2 Soil). Underlying soils from 0.5 to 5.0 feet or deeper is classified as non-hazardous waste. Based on statistical analysis of combined soil layers, we have the following results:

- For location nos. 2 and 20, if soil excavated from surface to a depth of 5.0 feet or deeper are managed as a whole, then it could be classified as non-hazardous waste.
- For location nos. 10 and 17, if soil excavated from surface to a depth of 2.0 feet or deeper are managed as a whole, then it could be classified as non-hazardous waste.

Location Nos. 7, 13, 14, and 16 (4 locations)

Excavated soils from the surface to a depth of 2.0 foot would be considered as California hazardous waste (Caltrans Type Y-1 or Z-2 Soil). Underlying soils from 2.0 to 5.0 feet or deeper is classified as non-hazardous waste. Based on statistical analysis of combined soil layers, we have the following results:

- For location no. 7, if soil excavated from surface to a depth of 3.0 feet or deeper are managed as a whole, then it could be classified as non-hazardous waste.

If ADL contaminated soils need to be disposed to a landfill facility, please refer to the latest Contract Cost Database at <http://t8web/design/contractcost/> for the most current estimate.

Title 22 Metals

Title 22 metals (other than lead) did not exceed their respective TTLCs. Cadmium was the only metal reported at a total concentration greater than 10 times STLC. The concentrations of all metals except lead were within the reported range of background concentrations.

pH

Soil pH ranged from 6.3 to 9.1 and the soil is suitable for reuse under the DTSC Variance based on pH. If soil is transported to offsite it would be considered as non-hazardous waste based on pH.

Total Petroleum Hydrocarbons (TPHs)

The total petroleum hydrocarbons in C28 to C40 range was reported for six (6) of 23 samples, and the concentration ranged from 15 to 140 mg/kg. The TPHs was reported in soil samples collected from location nos. 1 (depths from surface to 1 foot), 7 (depths from surface to 3 feet), 8

(depths from surface to 2 feet), and 20 (depths from 3 feet to 5 feet). The reported concentrations do NOT exceed the Environmental Screening Levels (ESLs) for industrial use land. However, since TPHs is present these soils can't be reused using Department of Toxic Substance Control (DTSC) Variance. These soils should be disposed of at a permitted landfill facility. Please refer to the latest Contract Cost Database at <http://t8web/design/contractcost/> for the most current estimate.

Volatile Organic Compounds (VOCs) and Semi-Organic Organic Compounds (SVOCs)

There is only one (1) soil sample collected from location 20 was reported to contain 4-isopropyltoluene at a concentration of 7.3 mg/kg, however, there is no risk based screening levels for soil or MCL-based screening levels available for 4-isopropyltoluene. Excavated soils from these locations would be classified as non-hazardous waste with respect to VOCs and SVOCs content.

Please notify the hazardous waste branch if there is any change in the scope of work. If you have any questions or need any more information, please contact me at extension 7-0670 or Jack Liu of my staff at 7-1350.



Ayubur Rahman, P. E.
Senior Transportation Engineer
Hazardous Waste Coordinator, North Region

Table 1. Proposed BMP Sites

Location Number	Site No – From Corridor Study	PM	Type	Side (EB/WB) – Cross St	Proposed Depth of Device ft
1	^a	15.9	Austin or Delaware Sand Filter	EB – Honolulu Ave	16*
2	^a	19.75	Austin or Delaware Sand Filter	EB – Angeles Crest Hwy	16*
3	44 ^b	27	Austin Vault Sand Filter	WB – Hill Ave	16*
4	49 ^b	27.49	Austin Vault Sand Filter	WB – Allen Ave	16*
5	52 ^b	27.73	Austin Vault Sand Filter	WB – Craig Ave	16*
6	53 ^b	27.94	Austin Vault Sand Filter	WB – Martelo Ave	16
7	61 ^b	28.53	Austin Vault Sand Filter	EB – San Gabriel Blvd	16*
8	65 ^b	28.79	Austin Vault Sand Filter	EB - Sunny Slope Ave	16*
9	83 ^b	29.69	Delaware Sand Filter	EB – Michillinda Ave	14*
10		31.15	Infiltration Trench	EB – 5 th Ave	4.33
11	121 ^b	32.83	Infiltration Basin	EB – Huntington Drive	5.3
12	129 ^b	33.73	Delaware Sand Filter	EB – Magnolia Ave	14*
13	138 ^b	34.37	Infiltration Trench	WB – Shamrock Ave	4.3
14	142 ^b	34.66	Delaware Sand Filter	WB – Mountain Ave	14*
15	144 ^b	34.84	Infiltration Trench	WB – Bradbury Ave	5.3
16	147 ^b	35.05	Infiltration Trench	WB – Buena Vista Ave	4.33
17	150 ^b	35.29	Delaware Sand Filter	WB - Brycedale Ave	14*
18	88	29.83	GSRD/Biofiltration Strip Combination	WB – Michillinda Ave	N/A
19	96	30.64	GSRD/Biofiltration Swale Combination	WB – Baldwin Ave	N/A
20	108A	31.94	GSRD/Biofiltration Strip Combination	WB – Santa Anita Ave	N/A
21	120	32.83	GSRD/Biofiltration Swale Combination	WB – Huntington Ave	N/A

^a – Proposed BMPs Sites are not selected from Corridor Study^b - Proposed BMPs Sites are selected from Corridor Study

* - Device depth not finalized at this point, maximum allowable Design Height provided. (Allow an additional 1 ft for concrete footing for excavation depth).

Table 2. Summary of ADL Test Results

Location Number	Site No.	PM	Boring Nos.	ADL Test Results	Soil Type
1	- ^a	15.9	1134-101 & 102	No HW Concern	X
2	- ^a	19.75	1134-103 & 104	Surface to 0.5 feet (HW)	Y-1/Z-2
3	44 ^b	27	1134-105 & 106	No HW Concern	X
4	49 ^b	27.49	1134-107 & 108	No HW Concern	X
5	52 ^b	27.73	1134-109 & 110	No HW Concern	X
6	53 ^b	27.94	1134-111 & 112	No HW Concern	X
7	61 ^b	28.53	1134-113 & 114	Surface to 2.0 feet (HW)	Y-1/Z-2
8	65 ^b	28.79	1134-115 & 116	No HW Concern	X
9	83 ^b	29.69	1134-117 & 118	No HW Concern	X
10	115	32.48	1134-119 & 120	Surface to 0.5 feet (HW)	Y-1/Z-2
11	121 ^b	32.83	1134-121 & 122	No HW Concern	X
12	129 ^b	33.73	1134-123 & 124	No HW Concern	X
13	138 ^b	34.37	1134-125 & 126	Surface to 2.0 feet (HW)	Y-1/Z-2
14	142 ^b	34.66	1134-127 & 128	Surface to 2.0 feet (HW)	Y-1/Z-2
15	144 ^b	34.84	1134-129 & 130	No HW Concern	X
16	147 ^b	35.05	1134-131 & 132	Surface to 2.0 feet (HW)	Y-1/Z-2
17	150 ^b	35.29	1134-133 & 134	Surface to 0.5 feet (HW)	Y-1/Z-2
18	88	29.83	1134-135 & 136	No HW Concern	X
19	96	30.64	1134-137 & 138	No HW Concern	X
20	108A	31.94	1134-139 & 140	Surface to 0.5 feet (HW)	Y-1/Z-2
21	120	32.83	1134-141 & 142	No HW Concern	X

^a – Proposed BMPs Sites are not selected from Corridor Study

^b – Proposed BMPs Sites are selected from Corridor Study

* - Device depth not finalized at this point, maximum allowable Design Height provided. (Allow an additional 1 ft for concrete footing for excavation depth).

State of California

Business, Transportation and Housing Agency

M e m o r a n d u m

*Flex your power!
Be energy efficient!*

To: **MR. NADER GOBRAN**
Senior Transportation Engineer
District 7- Office of Design D

Date: February 2, 2012
File: 07- LA -210 PM R15.0/R36.0
07-258931 (0700000481)
Austin Vaults Sand Filters
Nos. 3, 4, 5, 6, 7, 8, 9, 14, 15, 17

Attention: Ms. Sujaya Kalainesan

From: DEPARTMENT OF TRANSPORTATION
DIVISION OF ENGINEERING SERVICES
Geotechnical Services
Office of Geotechnical Design - South 1

Subject: Plan Review Comments and Geotechnical Review Comments for Construction of Austin Vaults Sand Filters at Interstate 210, Near Pasadena, County of Los Angeles

The Office of Geotechnical Design South 1 (OGDS1), Branch D has reviewed project plans dated January 27, 2012 provided by the Office of Design D. Based on the review and our verbal communications on the above project, OGDS1 has the following comments on the geotechnical issues at the subject Austin vault sand filters.

1. The plans indicate that some of the proposed vaults would be constructed on the lower portions of slopes that contain sound walls typically located at the top of the slope. It is our understanding that the nearest walls of the vault would be constructed at distances ranging from 5 to 7 feet from the sound walls. The slope below the sound walls would be regraded in the project to provide a slope ratio of 1:2 (vertical: horizontal).
2. Some of the sound walls are supported on pile foundations.
3. The Caltrans Standard Plans indicate that the descending slopes below sound walls should be no steeper than 1:2 (vertical: horizontal). They also indicate that the sound wall foundation should be located on flat grade at a distance no less than 1 foot from the hinge point of the slope. Our review of the plans indicates that at location Nos. 3, 4, and 6, the downward slope initiates from/near the faces of sound walls and therefore may not be in compliance with the Standard Plans. We recommend that the District Design provide the design loads to OGDS1 for necessary analysis. Based on the loading provided, OGDS1 would evaluate the capacity of pile foundations at such locations to verify their adequacy.

Construction Recommendations

- (a) All excavations for vaults should be performed with permanent shoring that could be either incorporated into the vaults or left in place as separate structures for the design life of the vaults.
- (b) Shoring should consist of soldier pile-lagging system. The contractor should evaluate the lateral deflection of the shoring elements and monitor during the construction for compliance with

MR. NADER GOBRAN

February 2, 2012

Page 2

Austin Vaults Sand Filters Nos. 3, 4, 5, 6, 7, 8, 9, 14, 15, 17

07-258931

the design. The maximum deflection allowed in shoring is 1/2 inch; and this limit should not be exceeded anytime during the construction. Depending on the slope and excavation heights, tie-back systems may be needed.

(c) The shoring should be designed based on the procedures outlined in Caltrans Bridge Design Specifications. For the design, a friction angle of 32 degrees and zero cohesion should be assumed. The unit weight of 130pcf should be assumed for the retained material. There is no groundwater at the site.

(d) The soldier pile/anchor system should be built using a top-down construction method.

(e) The lagging should consist of either timber, treated to last for the design life of the project, or appropriately designed concrete panels. The shoring should be provided with appropriate drainage features to mitigate a hydrostatic pressure build up behind the wall. The drainage system should be approved by the engineer.

(f) In the case that an anchored system is used, the anchors should be installed in between the sound wall piles at a downward angle of 15 degrees from the horizontal. The anchors should have a minimum unbonded length of 15 feet. However, the bonded zones of the anchors should be located a minimum distance of 10 feet behind the sound wall piles. The anchors should be installed and tested in accordance with applicable Caltrans procedures.

(g) The soldier pile/anchor wall systems can be incorporated into the proposed Austin vault structure or left in place as separate structures. If the anchored walls are incorporated into the vault, then appropriate measures should be provided to outlet the drainage from the retained soil.

Please call Gamini Weeratunga at (949) 440-3427 or Shiva Karimi at (213) 620-2146, with any questions you may have on the above comments.

Prepared by:

Date: 2/2/2012

Gamini Weeratunga, C.E.
Transportation Engineer
OGDS1, Branch D



Reviewed by:

Date: 2/2/2012

Shiva Karimi, Ph.D.
Senior Transportation
OGDS1, Branch D



cc.

District Project Manager	Ojas Sheth	Ojas_Sheth@dot.ca.gov
GS Corporate	Shira Rajendra	Shira_Rajendra@dot.ca.gov
District Materials Engineer	Kirsten Stahl	Kirsten_Stahl@dot.ca.gov




CONDUIT AND CONDUCTOR SCHEDULE												
		P' IN					P' FT.					
		1/1	1/2	1/3	1/4	1/5	1/6	1/7	1/8	1/9	1/10	1/11
DLC	QUEUE DETECTOR	1	1	1	1	2	2	2	3	2	2	3
	DEMAND DETECTOR									2	2	2
	PASSAGE DETECTOR									2	2	2
	SURVEILLANCE DETECTOR					4				4		4
	COUNT DETECTOR				1	1				1	2	4
9CSC	RAMP METERING SIGNAL									3	3	3
5CSC	"METER-ON" SIGN, FLASHING BEACON	1	1	1	2	2	2	4	5			5
#4	RAMP METERING SERVICE / TDC				4	4	4	2	2			2
#8	GROUND				1	1	1	1	1	1	1	1
CONDUIT SIZE (mm)		63	63	63	78	53	63	63	103	78	78	2-78


卷之三

DESIGNER'S

ESTUARIES

卷之三

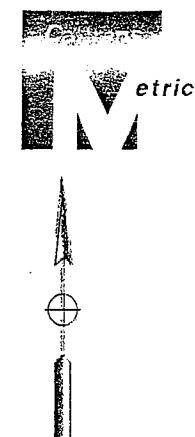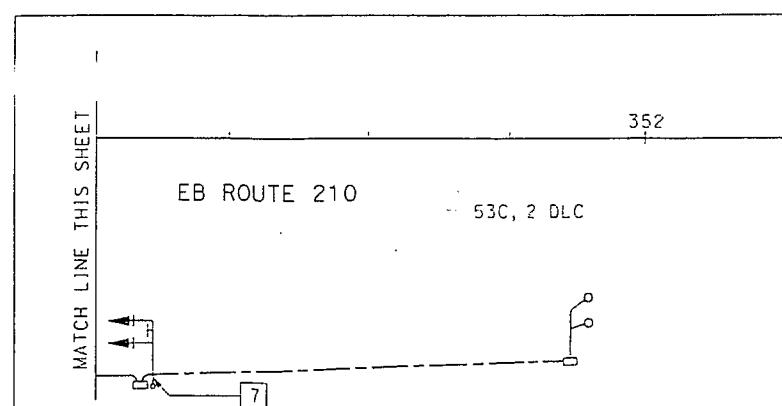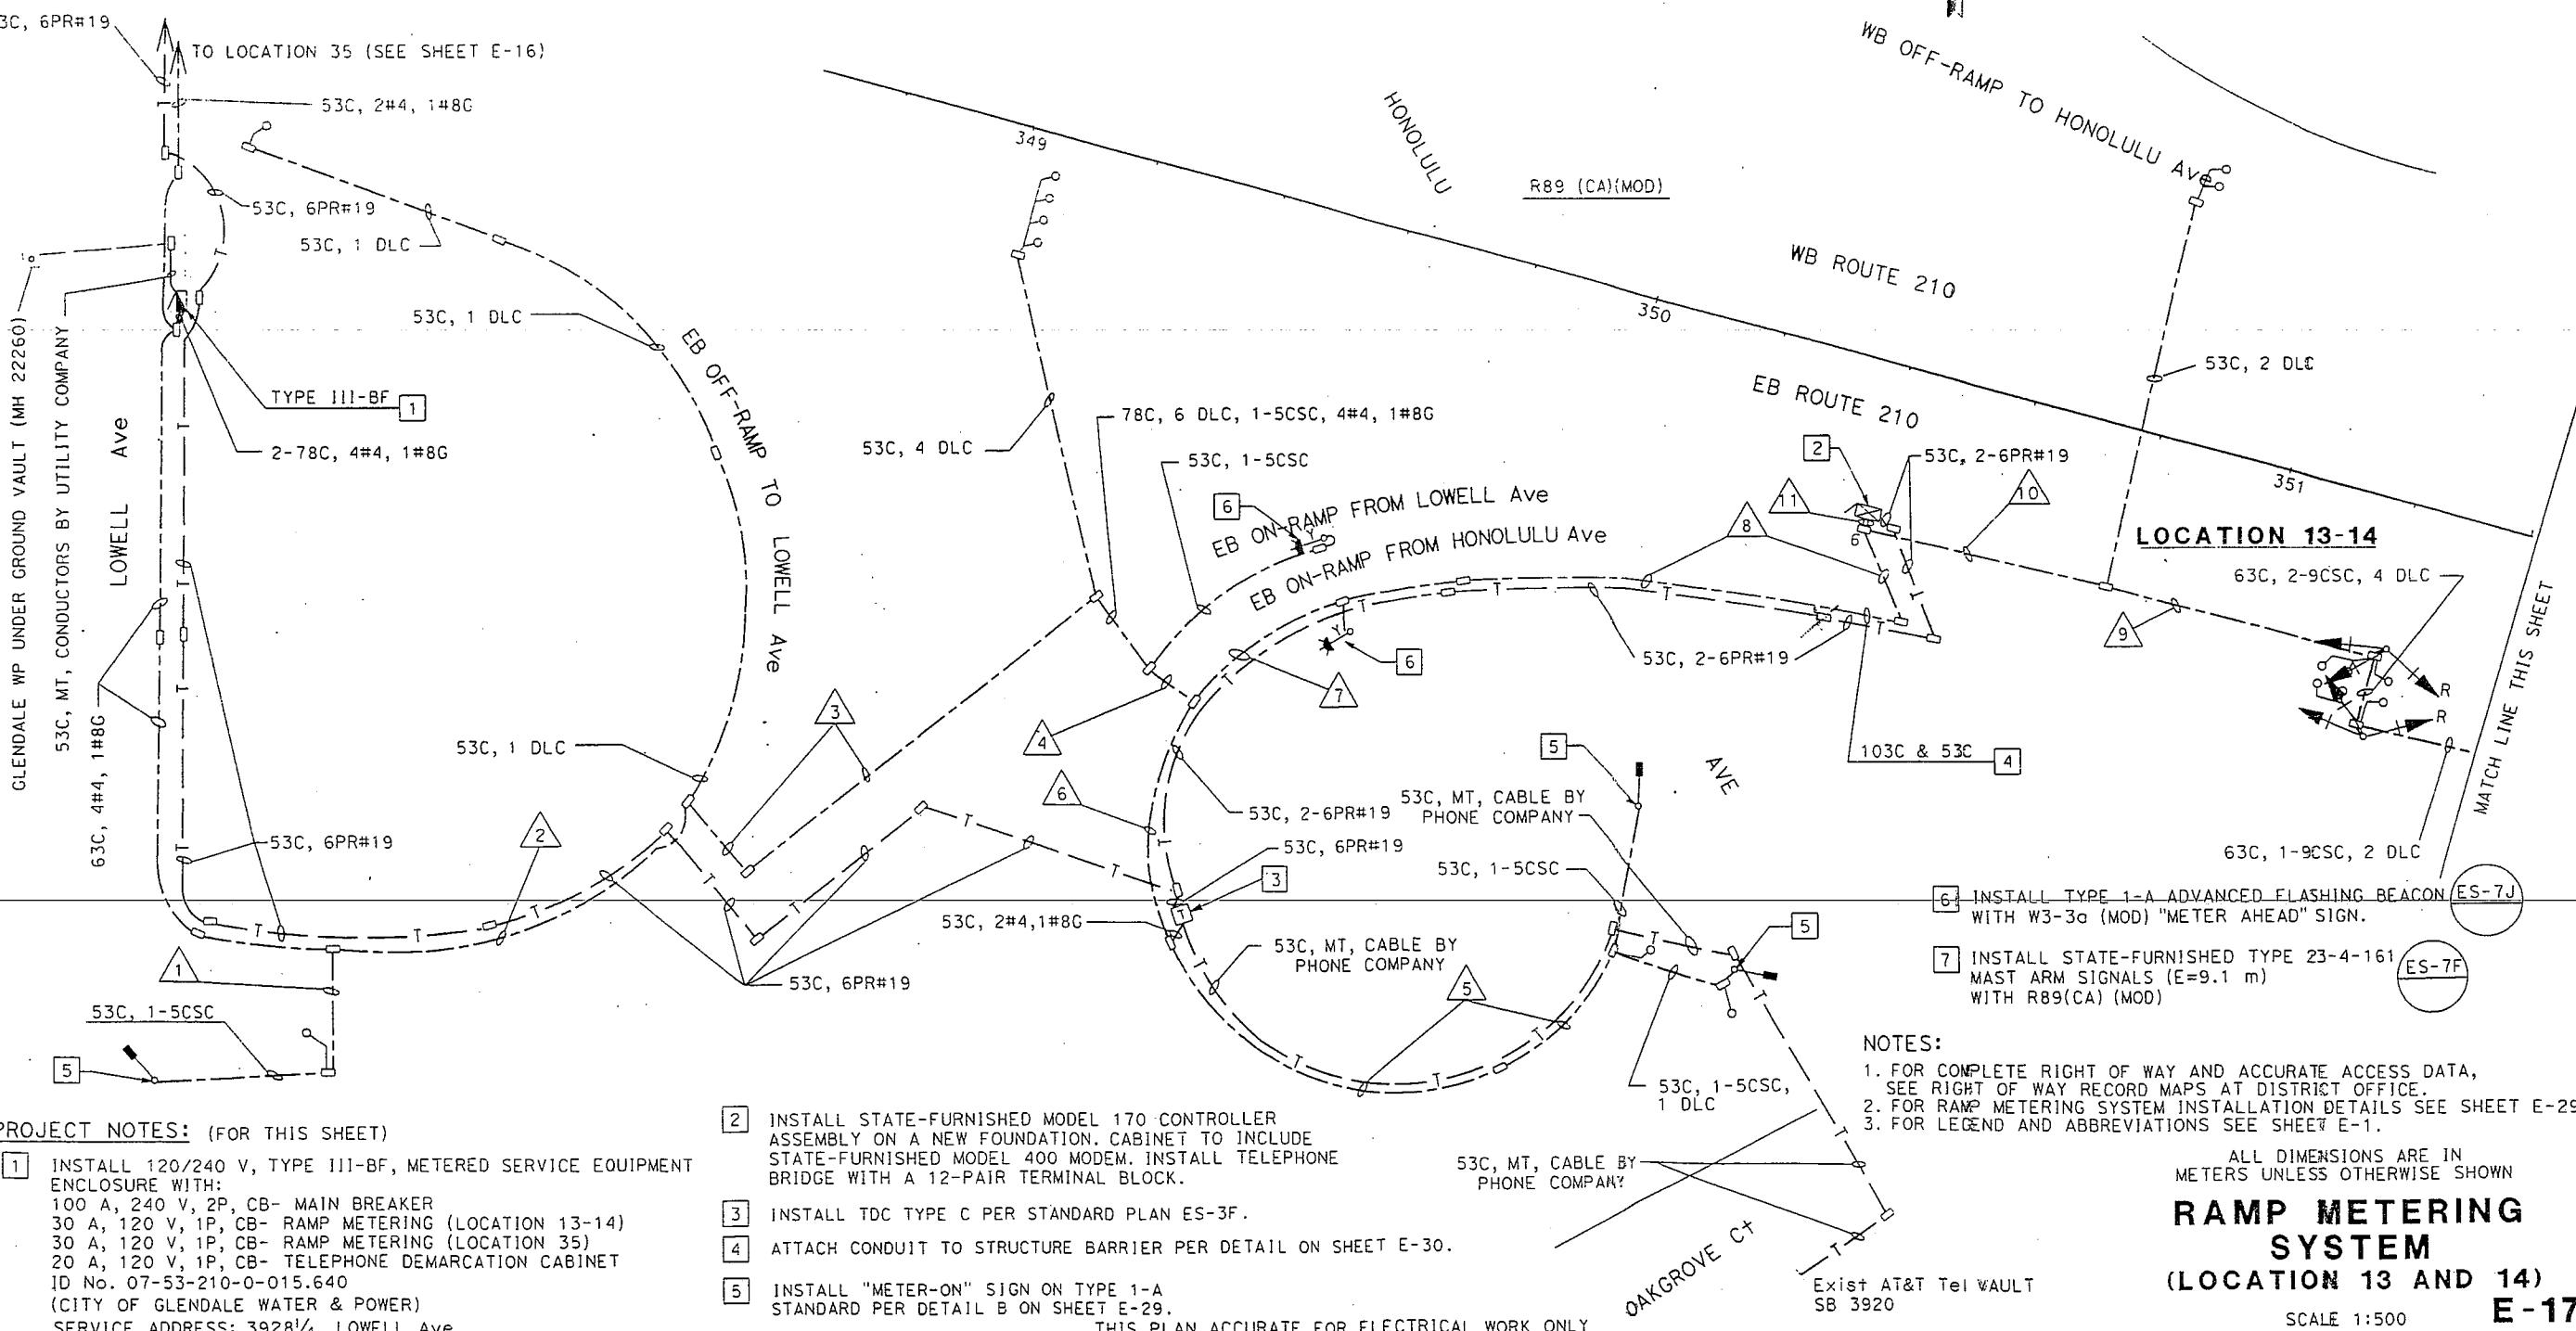

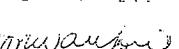PRINTED NAME	ADDRESS	PHONE NUMBER	EXPIRATION DATE	TYPE	TOTAL SHEETS
07 LA	210	R1.0/R40.4	177	1	286
 HON WAI YOW EXP. 3/31/08 * CIVIL					
12-18-06					
FEE APPROVAL DATE					
ACT CONSULTING ENGINEERS 5 CORPORATE PARK SUITE 260 IRVINE, CA 92606					

00-00-00 FILED FEB 11 1966 1:30:03 P.M. 1966 BUREAU OF INVESTIGATION

STATE OF CALIFORNIA - DEPARTMENT OF TRANSPORTATION
California

CALCULATED BY: J. SHIAO
DESIGNED BY: CECILIO BURCIAGA
CHECKED BY: S. YEH

DATE REVISED BY: 10/06
DATE REVISED: 10/06

DATE REVISED BY: J. SHIAO
DESIGNED BY: CECILIO BURCIAGA
CHECKED BY: S. YEH

DATE REVISED BY: J. SHIAO
DESIGNED BY: CECILIO BURCIAGA
CHECKED BY: S. YEH

SEE DETAIL A
SHEET E-23

53C, 2#4, 1#8G
63C, 1-5CSC, 2#4, 1#8G
WB OFF-RAMP TO ANGELES CREST Hwy

LOCATION 30

TO
LOCATION 31
SEE SHEET
E-23

53C, 6PR#19

63C, 1-5CSC, 2 DLC, 2#4, 1#8G

53C, 6PR#19

63C, 1-5CSC, 2 DLC, 2#4, 1#8G

53C, 6PR#19

WB ON-RAMP FROM ANGELES CREST Hwy

53C, 1 DLC

53C, 4 DLC

MVP

53C, 6PR#19

53C, 1-9CSC

53C, 1-5CSC

53C, 1-5CSC, 1 DLC

53C, 1-5CSC

NOTES (This Sheet)

1. INSTALL MODEL 170 CONTROLLER ASSEMBLY.(STATE FURNISHED)
 2. INSTALL TELEPHONE JACK AND CIRCUIT BREAKER.
 3. INSTALL NO.5 PULL BOX WITH STEEL "TRAMP METER" COVER.
 4. INSTALL TYPE A TELEPHONE SERVICE.
 5. INSTALL TELEPHONE JUGE.
 6. INSTALL 120/240V. TYPE III-BF UNMETERED SERVICE WITH 40 AMP.(RAMP METER) AND 20 AMP.(DEMARCATION BOX) CIRCUIT BREAKERS.

07-63-210-f-026.941 (CITY OF PASADENA)


 7. INSTALL TYPE 1-A, 7' STANDARD WITH TP-1 MOUNTING BRACKET AND ONE SIGNAL HOUSING MOUNTED ON TOP OF ANOTHER. TOP MESSAGE SHALL READ "10 MIN. DELAY". BOTTOM MESSAGE SHALL READ "METER ON".

07-63-210-FI-026.941 (CITY OF PASADENA)

INSTALL TYPE 1-A 7' STANDARD WITH TP-1 MOUNTING BRACKET AND ONE SIGNAL HOUSING MOUNTED ON TOP OF ANOTHER. TOP MESSAGE SHALL READ "10 MIN. DELAY", BOTTOM MESSAGE SHALL READ "METER ON".

CONDUCTOR SCHEDULE												
AWG	CIRCUIT	RUN										
		1	2	3	4	5	6	7	8	9	10	12
	14 AWG 8 CONDUCTORS											
	12 AWG 6 CONDUCTORS											
	10 AWG 4 CONDUCTORS											
	8 AWG 3 CONDUCTORS											
* 10	SIGNAL COMMON				1	1					1	
* 8	SERVICE						2	2	2			
* 4 AWG 10 CABLE	TELEPHONE SER.										1	2
	COUNT DETECTOR	4	1	11		11	1		1	12		
2 AWG 12	DEMAND DETECTOR				1	2				2		
DLC	PASSAGE DETECTOR				1	2				2		
	QUEUE DETECTOR								1	2	2	
* 12	DEMARCATION SERV.						2					

(X) = SHIELDER CAB

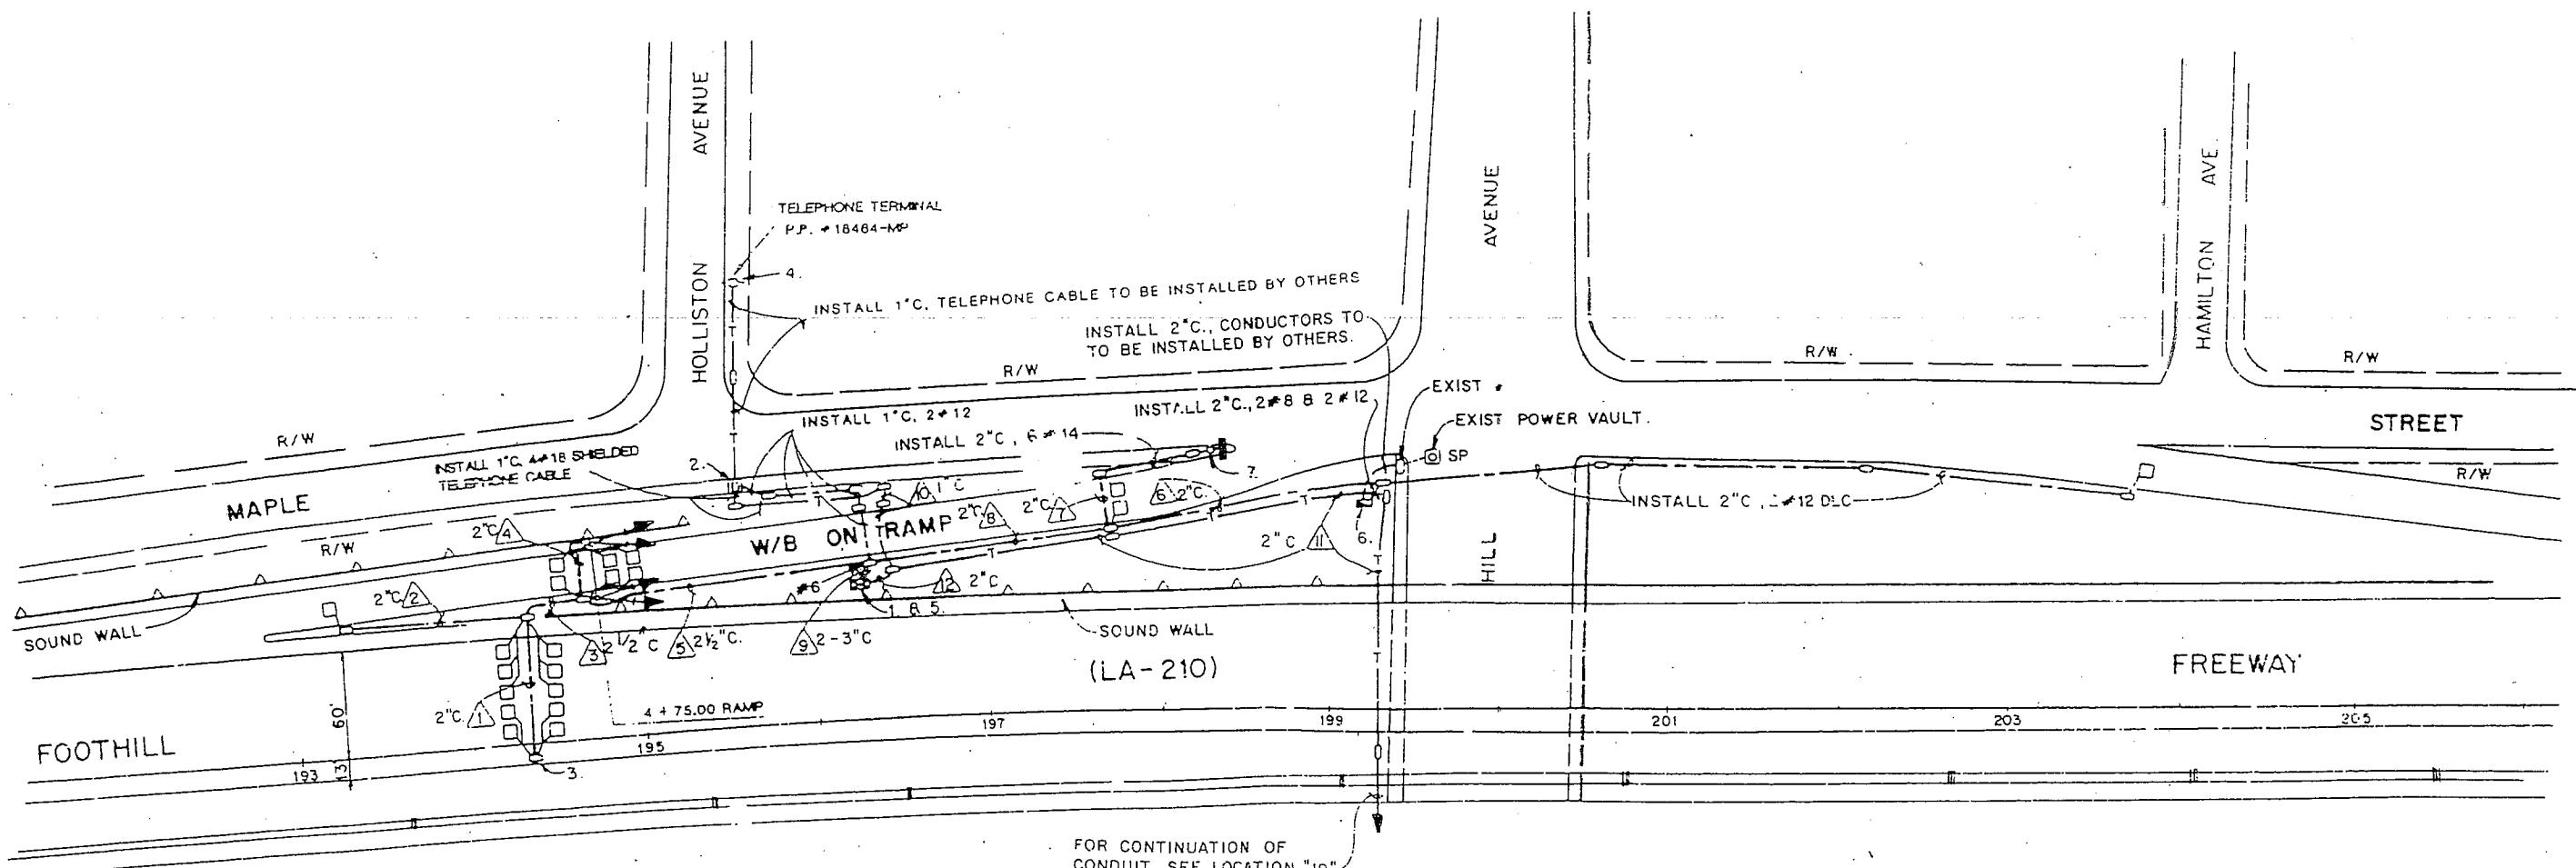

AS BUILT PLANS
Contract No. 07-443509
Date Completed 08/15/88
Document No. _____

LOCATION "1


—

AS BUILT

CONTRACT NO. 44-504
RESIDENT ENR. 12/22/88
DATE CONTRACTED 8/15/88

LOCATION "18"
RAMP METERING PLAN
FOOTHILL FREEWAY
W/B ON RAMP
AT
HILL AVENUE


NOTE: THIS PLAN ACCURATE FOR ELECTRICAL ONLY

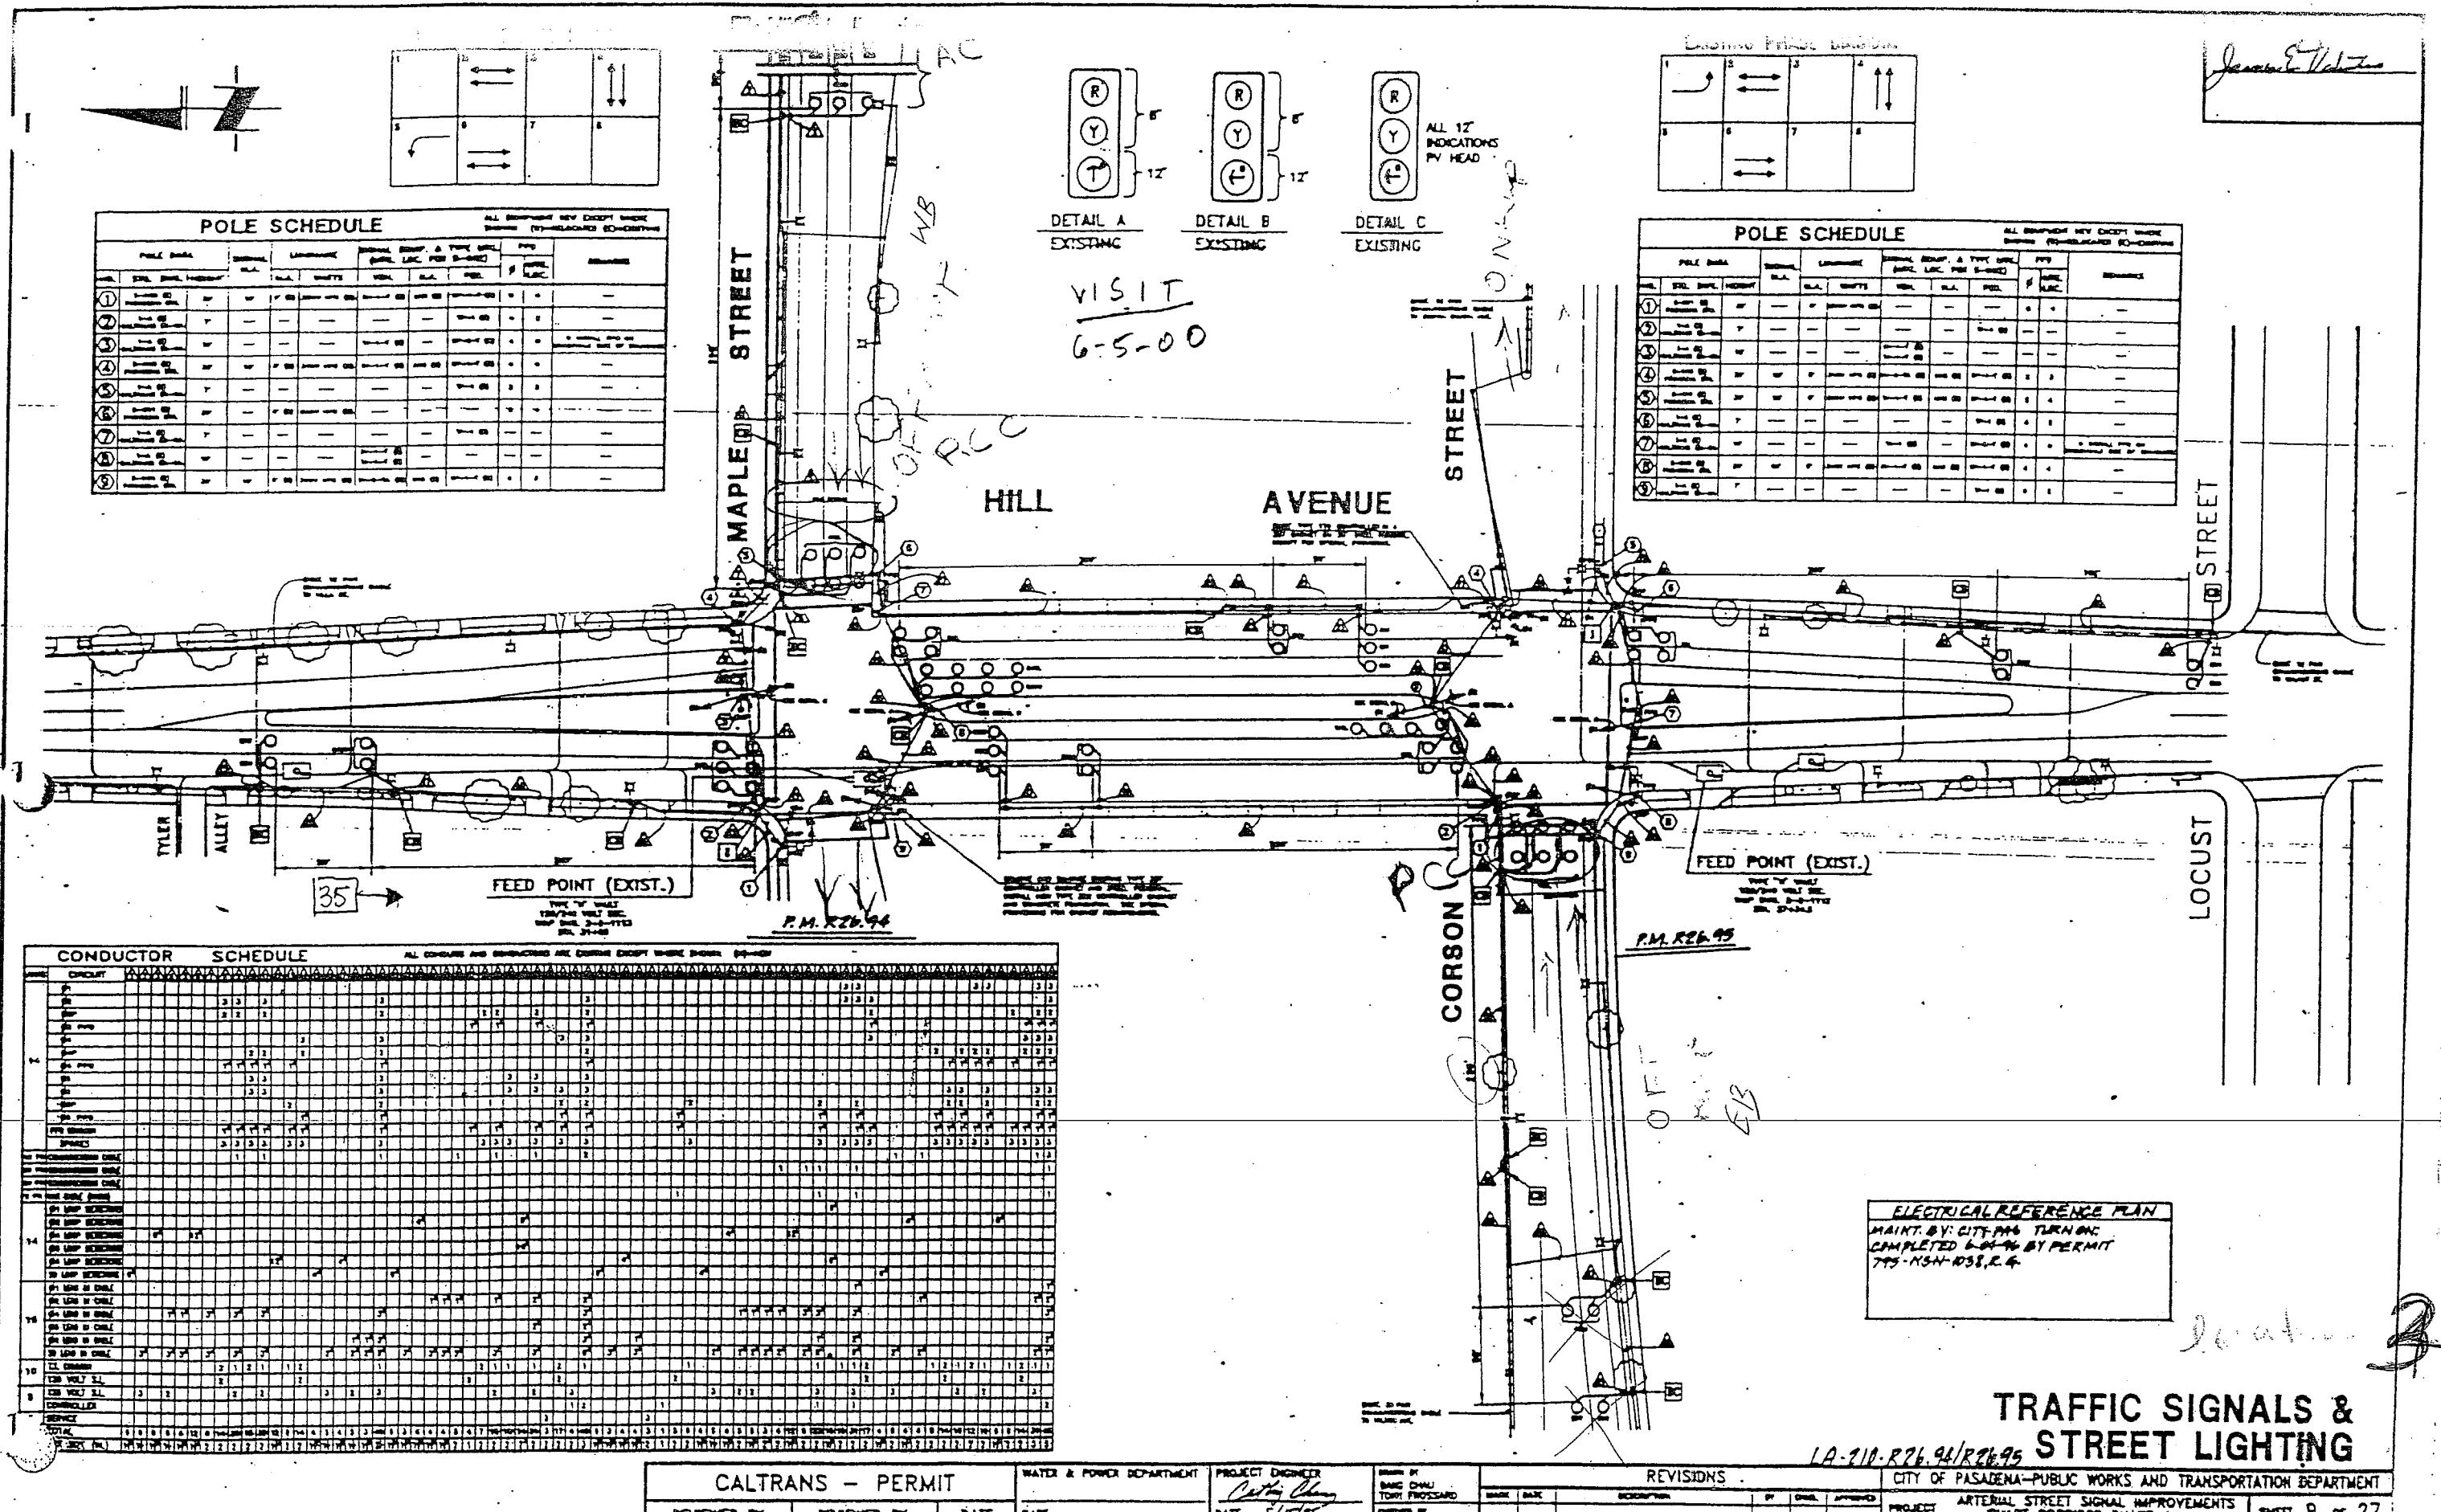

TRAFFIC SIGNALS & STREET LIGHTING

LA-210-R26.94/R26.95 STREET LIGHTING

CALTRANS - PERMIT			WATER & POWER DEPARTMENT	PROJECT ENGINEER <i>Cathy Chang</i>	ISSUED BY BASIC CHART TOMY FROSSARD	REVISIONS			CITY OF PASADENA-PUBLIC WORKS AND TRANSPORTATION DEPARTMENT		
REVIEWED BY	REVIEWED BY	DATE	DATE	DATE	ISSUED BY	BASIC	REVISION	BY	DATE	APPROVED	PROJECT
									ARTERIAL STREET SIGNAL IMPROVEMENTS		
									SMART CORRIDOR PHASE 1A		
									SHEET	9 OF 27	

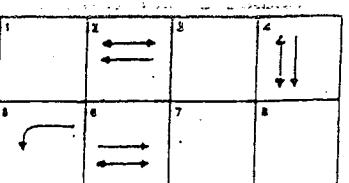

POLE SCHEDULE		ALL EQUIPMENT AND LUMPS WHERE SIGNALS ARE LOCATED ON ONE POLE					
POLE NUMBER	LOCATION	TYPE	TYPE	TYPE	TYPE	TYPE	TYPE
1							
2							
NOTE : THIS PLAN ACCURATE FOR ELECTRICAL WORK ONLY

LIGHTING AND SIGN ILLUMINATION

MODIFY

8044

EDNA A. H.

NIVAA, H.

03/1995

卷之三

FELLOW

Y

50'

3

— 1 —

EA 1

[View all posts by **John**](#) [View all posts in **Uncategorised**](#)

15

10

TIME PLOTTED > 23-MAR-1994 09:55
0-00-00
LAST REVISION

STATE OF CALIFORNIA - DEPARTMENT OF TRANSPORTATION	PROJECT ENGINEER	TRAFFIC DESIGN		R. PETERS	ROUTE	210	CARMELO
		CALCULATED BY	DATE REVISED BY				
Caltrans		CALCULATED BY	DATE REVISED BY				
		R/W	R/W				
AS-BUILT Contract No. 07- 118044 Resident Engineer: MANNA, H. Completion Date: 11/03/1995							
LIGHTING AND SIGN ILLUMINATION MODIFY SCALE: 1"=50'							
E-7							
NOTE : THIS PLAN ACCURATE FOR ELECTRICAL WORK ONLY							
<small>FORM DC-OE-92-PF (REV. 3/88)</small>		<small>FOR REDUCED PLANS ORIGINAL SCALE IS IN INCHES</small>				<small>USERNAME => richard DGN FILE => /usr/richard/PO/11804U07.d CU 07374 EA 118041</small>	

0 1 2 3

STATE OF CALIFORNIA - DEPARTMENT OF TRANSPORTATION

TRAFFIC DESIGN

R. PETERS

DATE REvised BY RP 9/93 DATE REvised FE 10/93

Calculated/Designed By

Project Engineer R. PETERS

Pat Sullivan C30912 No. Exp. 3-31-96 Civil State of California

POST MILE(S) SHEET NO. TOTAL SHEETS

DIST COUNTY ROUTE TOTAL PROJECT SHEET NO. TOTAL SHEETS

07 LA 210 R26.6/R32.9 14 42

3-21-94 PLANS APPROVAL DATE

NOTE : THIS PLAN ACCURATE FOR ELECTRICAL WORK ONLY

SERVICE EQUIPMENT

INSTALL 120/240-V METERED SERVICE IN TYPE III - BF SERVICE CABINETS C1, C2 EACH WITH A 1-100A, 2P, MAIN CIRCUIT BREAKER AND THE FOLLOWING BRANCH CBS.

NO	AMP	POLE	DESCRIPTION	CIRCUIT NO.
CABINET 1				
1-2	30	2	LIGHTING	12N
3	15	1	PEC/TYPE 5	
CABINET 2				
1-2	30	2	LIGHTING	12S

AS-BUILT

Contract No. 07- 118044
Resident-Engineer: MANNAH H.
Completion Date: 11/03/1995

LIGHTING AND SIGN ILLUMINATION

MODIFY


SCALE: 1"=50'

E-8

FOR REDUCED PLANS
ORIGINAL SCALE IS IN INCHES

0 1 2 3

00-00-00 TIME PLOTTED -> 23 MAR 1994 09:55 LAST REVISION

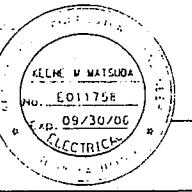

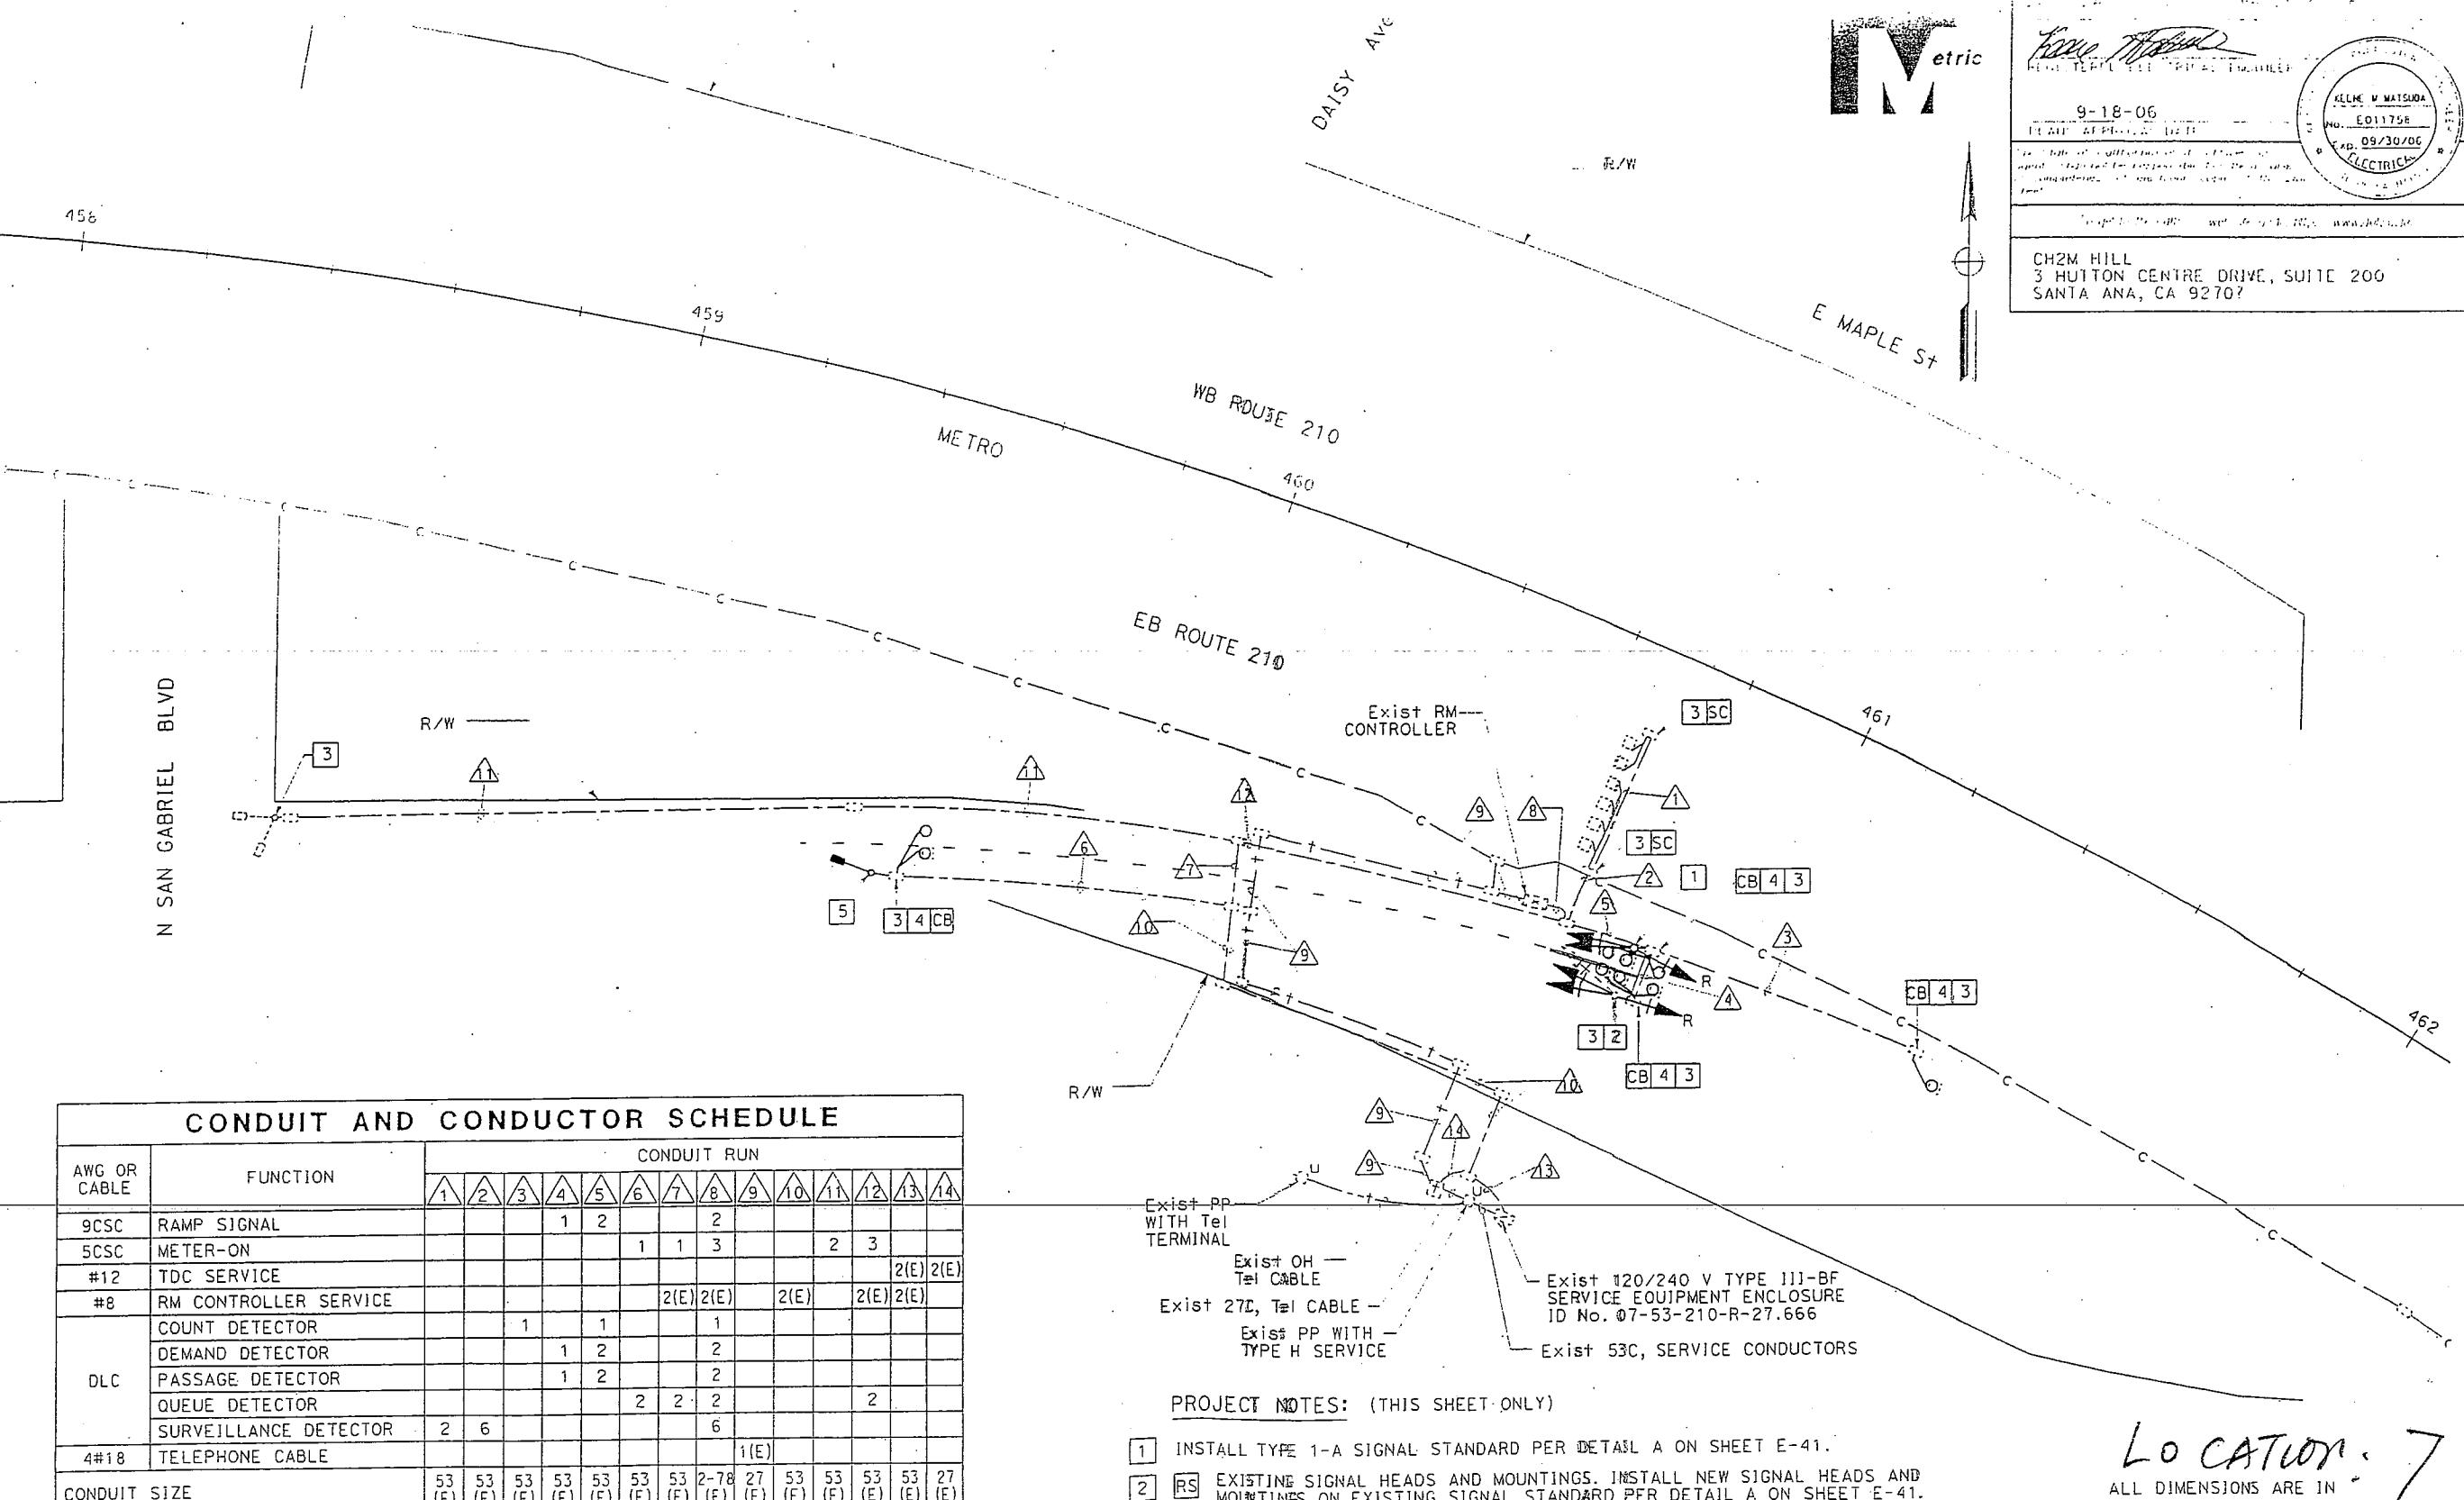
9-18-06

PLATE APPROVED BY [Signature]

NO. ED11756

EXP. 09/30/06

ELECTRICIAN

CH2M HILL
3 HUTTON CENTRE DRIVE, SUITE 200
SANTA ANA, CA 92707

STATE OF CALIFORNIA - DEPARTMENT OF TRANSPORTATION
Caltrans TRAFFIC DESIGN

TRAFFIC DESIGN

E&P *Trans*

CALCULATED BY		DATE	
DESIGNED BY	RP	9/93	REVISED BY
CHECKED BY	FE	10/93	DATE REVISED

卷之三

1 INSTALL SERVICE EQUIPMENT AS SHOWN IN TABLE FOR CABINET
 2 INSTALL SERVICE EQUIPMENT AS SHOWN IN TABLE FOR CABINET

1 INSTALL SERVICE EQUIPMENT AS SHOWN IN TABLE FOR CABINET 1.

2 INSTALL SERVICE EQUIPMENT AS SHOWN IN TABLE FOR CABINET 2.

THIS SHEET 1

07-53-210-R-028.71-1 15" RCP

NEW 2-10 CBB JS

330 SC AB MH

NO CONDUCTORS EXIST 2 #4

AT & SF RR 1290

NO CONDUCTORS EXIST 2 #4

8-6"+2-3" Pas Pwr
2-2-1043 770-u-794690 5/70

R/W ST R/W

11158 8" CI Pas Mun Wtr 15" NS 1 1/2" C R/W DR

6" CI Pas Mun Wtr 48" SW 24" RCP NEW 2 #8

16" Conic Stl Pas Mun Wtr 35" WE

8" Pas Mun Wtr 3.5" SH R/W LA TIERRA

NO CONDUCTORS

28761 SIGN NO 26 (606W)

28771

4 5

210

ROUTE

MERCEDES

RAMP NO. 17

RAMP NO. 18

CARSON

NO CONDUCTORS EXIST 2 #4

28671 28711 28741 28771

28732 28762

28802

28782 SIGN NO 25 (202W) TO ELECTROLIER 28822 CKT 135 CONTINUES

16" Conic Stl Pas Mun Wtr 35" WE

8" VCF Swr City of Pasadena c 3025 Sh 6 of 12

SERVICE EQUIPMENT

MAIN CABINET

118044 MANNAH 11031995

INSTAL 120/240-V METERED SERVICE IN TYPE III - BF SERVICE CABINETS CI, C2 EACH WITH A 1-100A, 2P. MAIN CIRCUIT BREAKER AND THE FOLLOWING BRANCH CBS.

NOTE : THIS PLAN ACCURATE FOR ELECTRICAL WORK ON

INSTALL 120/240-V. METERED SERVICE IN TYPE III - BF
SERVICE CABINETS C1, C2 EACH WITH A 1-100A, 2P, MAIN
CIRCUIT BREAKER AND THE FOLLOWING BRANCH CBS.

NO	AMP.	POLE	DESCRIPTION	CIRCUIT NO.
CABINET 1				
1-2	30	2	LIGHTING	13 N
3	15	1	PEC/TYPE 5	
CABINET 2				
1-2	30	2	LIGHTING	13 S
3	15	1	PEC/TYPE 5	

AS-BUILT 1118044
Contract No. 07-
Resident Engineer: MANNAGA, H.

LIGHTING AND SIGN ILLUMINATION

MODIFY

SCALE: 1" = 50'

E-10

FOR REDUCED PLANS 0 1
ORIGINAL SCALE IS IN INCHES

• USERNAME => lenard
DGN FILE => /usr/lenard/PO/71s804u10.dg


CU 07374 EA 11804

AMM DC-06-92-PF (REV. 3/88)

STATE OF CALIFORNIA - DEPARTMENT OF TRANSPORTATION

TRAFFIC DESIGN


PROJECT ENGINEER	R. PETERS
CALCULATED BY	RP 9/93
DESIGNED BY	FE 10/93

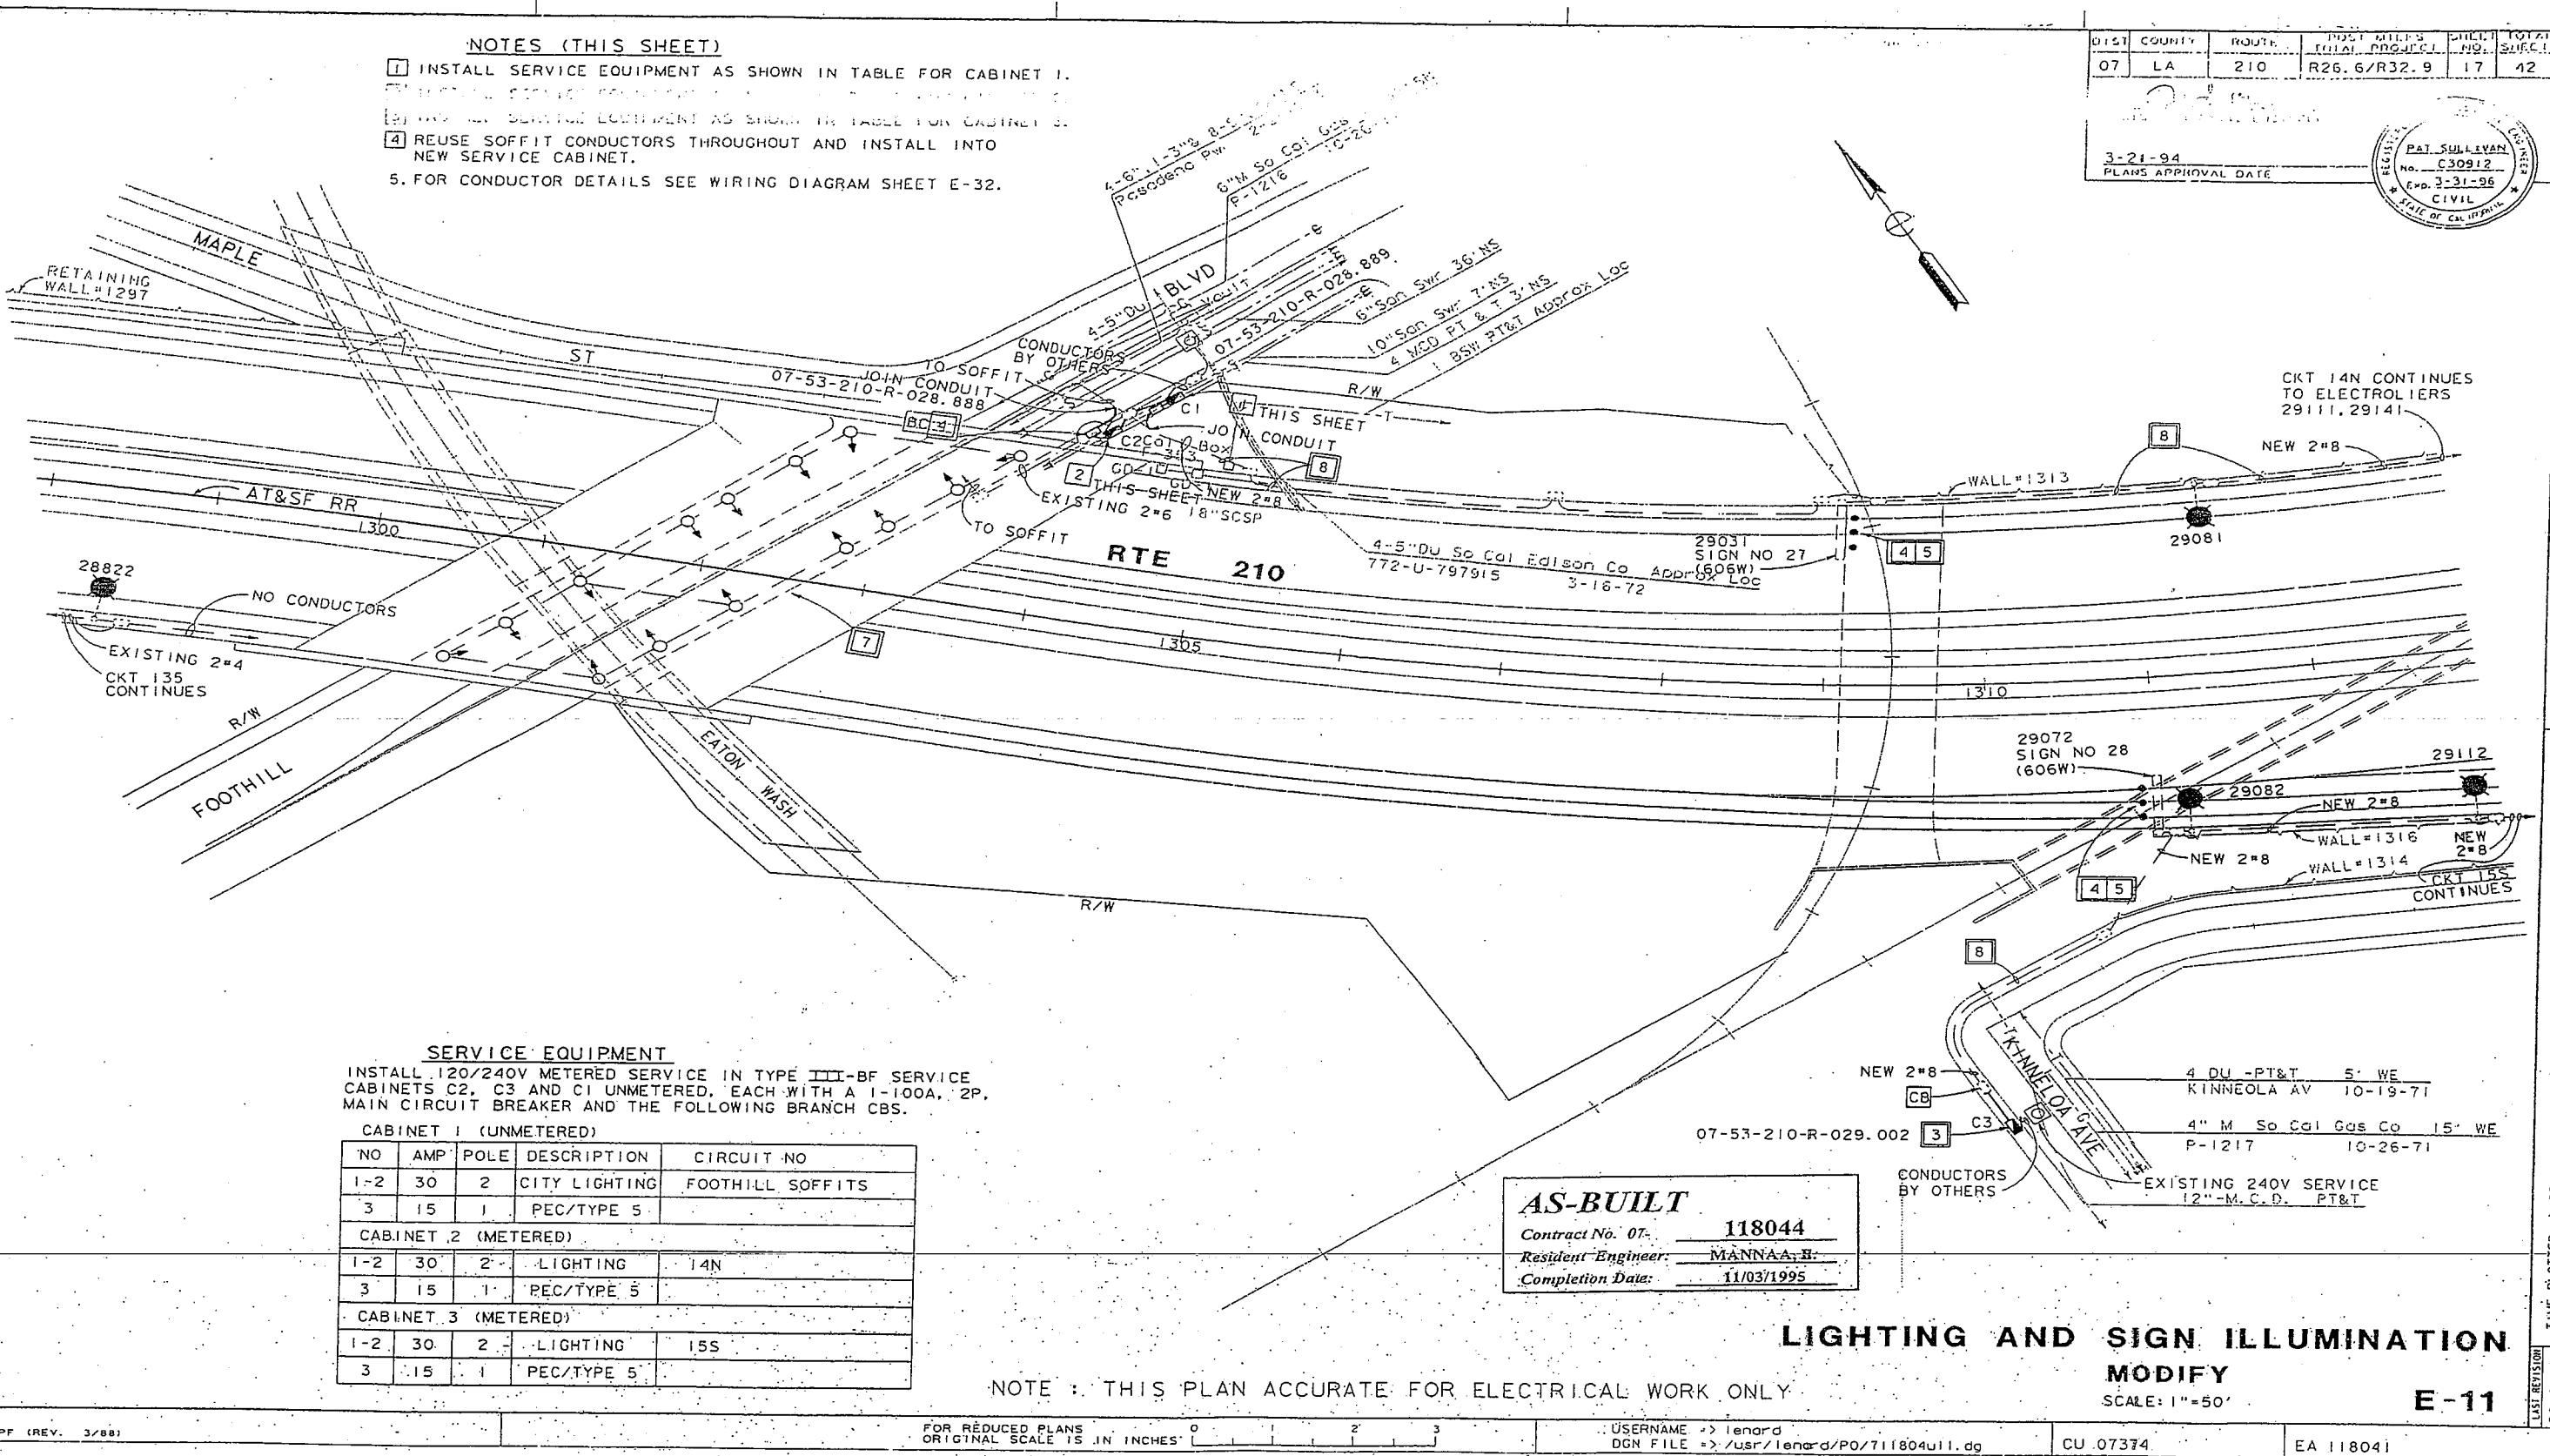

DATE APPROVED August 5, 1985

CONDUCTOR SCHEDULE													
LOCATION	CIRCUIT	1	2	3	4	5	6	7	8	9	10	11	12
4	ABANDON TO	4	5	7									
	ABANDON TO												
*14	SIGNAL	3	3										
	METER-ON												
	SPARE	3	3										
*10	SIGNAL COMMON	1	1										
*8	POWER SERVICE			2	2	2							

AS BUILT PLANS
Contract No 0498304
Date Completed 09/09/88
Document No.

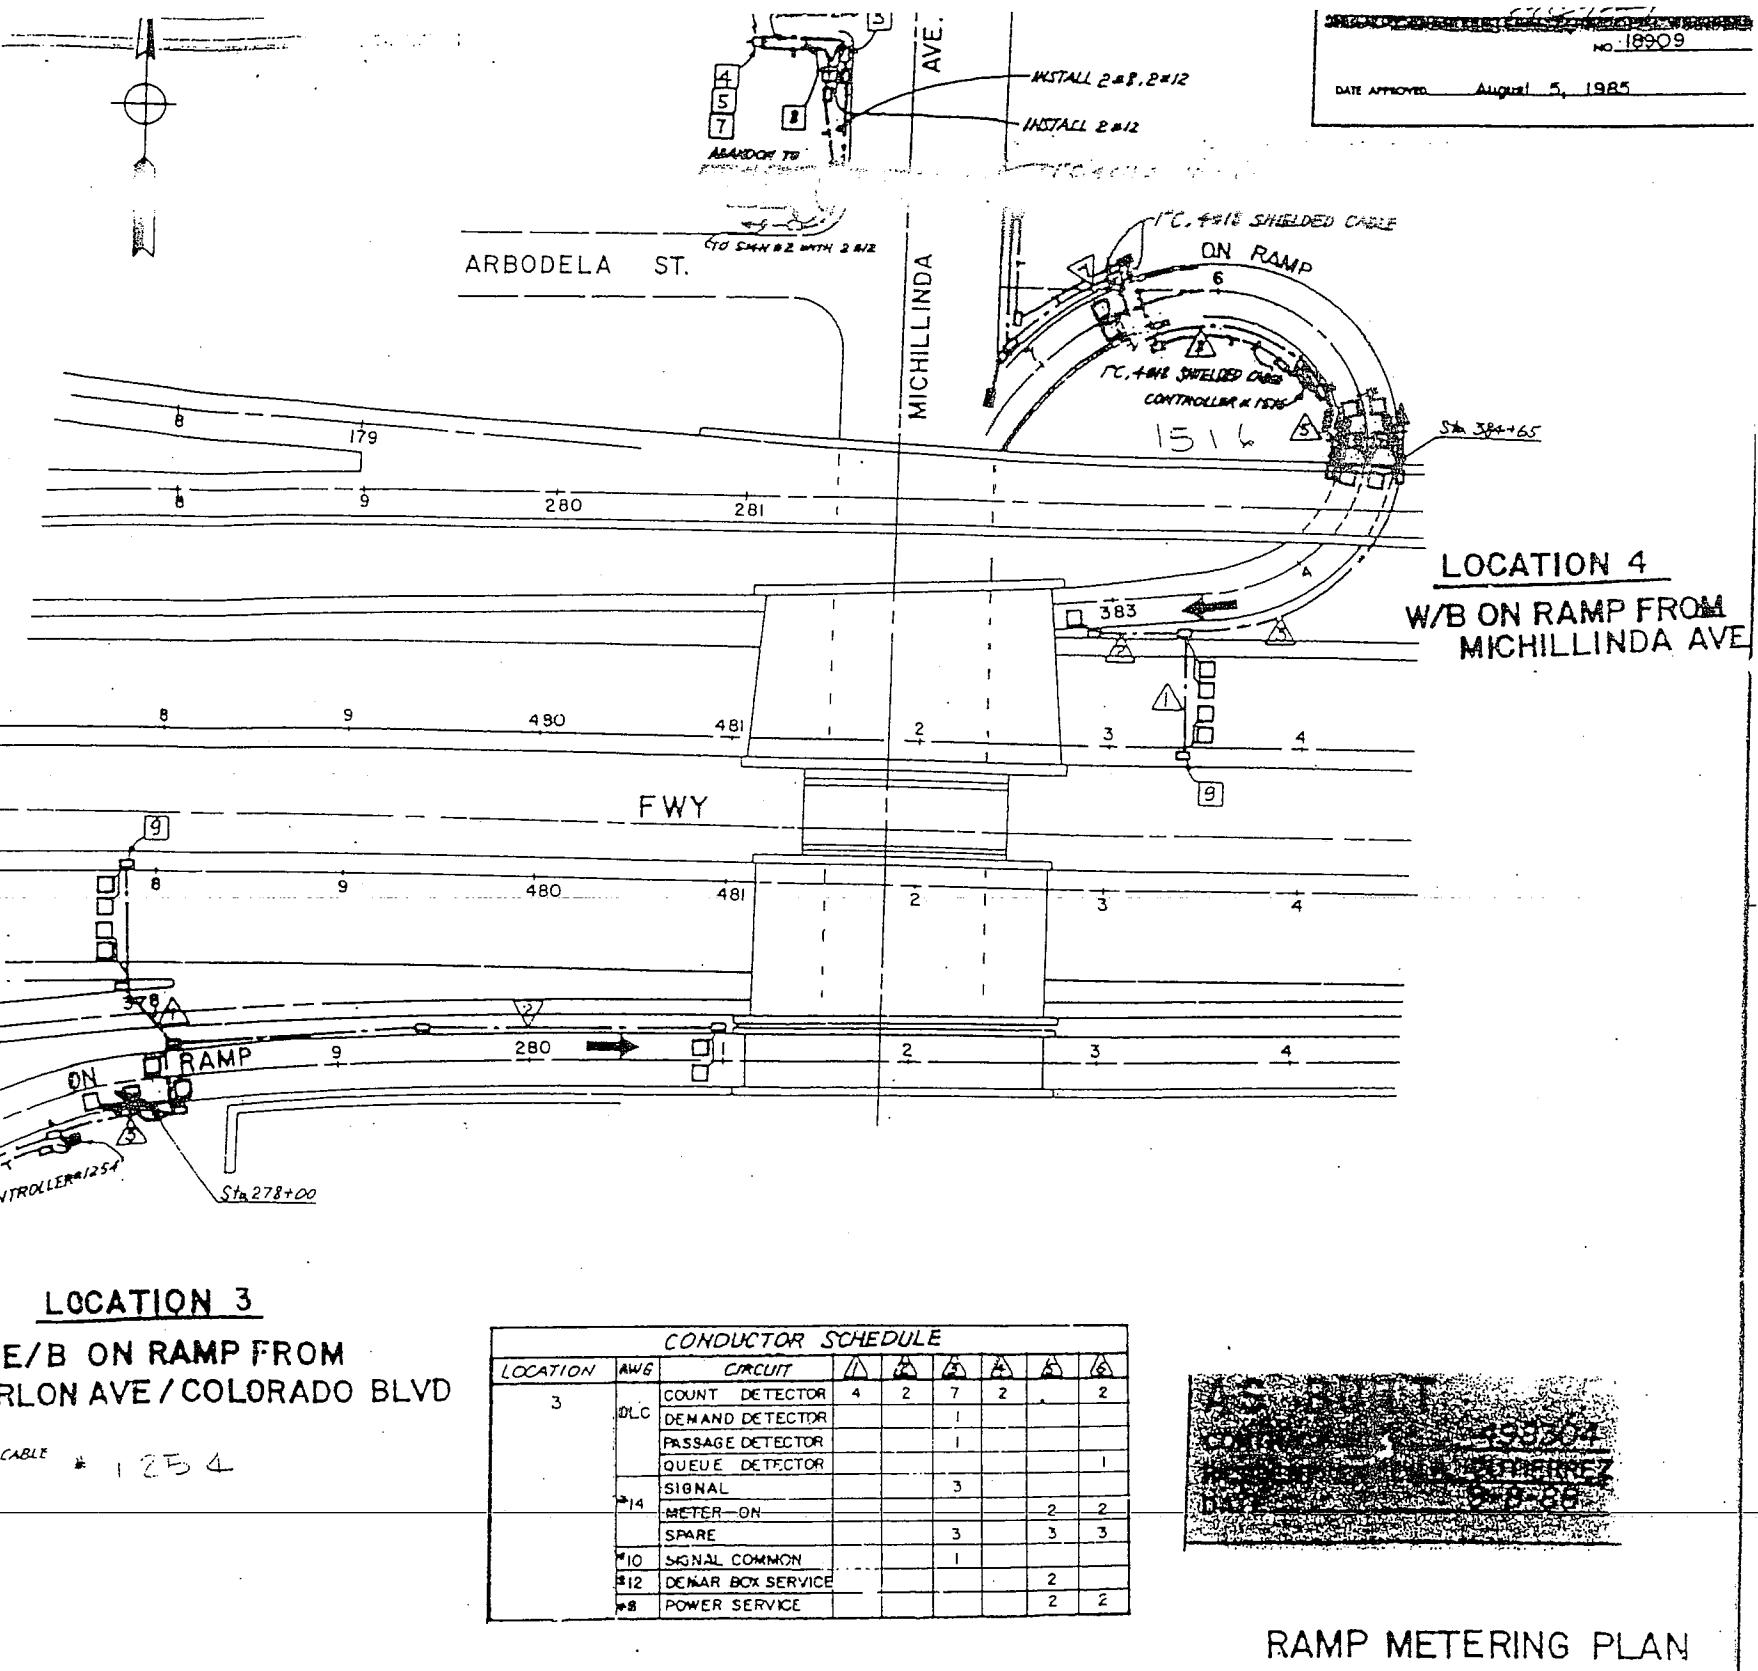

FOR PROJECT NOTES AND LEGEND SEE SHEET 1 OF ELECTRICAL PLANS.


NOTE THIS PLAN ACCURATE FOR ELECTRICAL ONLY


RAMP METERING PLAN
RTE 210 FWY
AT
MICHILLINDA AVE

6 10 100 700 FEET


07351-498301

30.1
Location 9

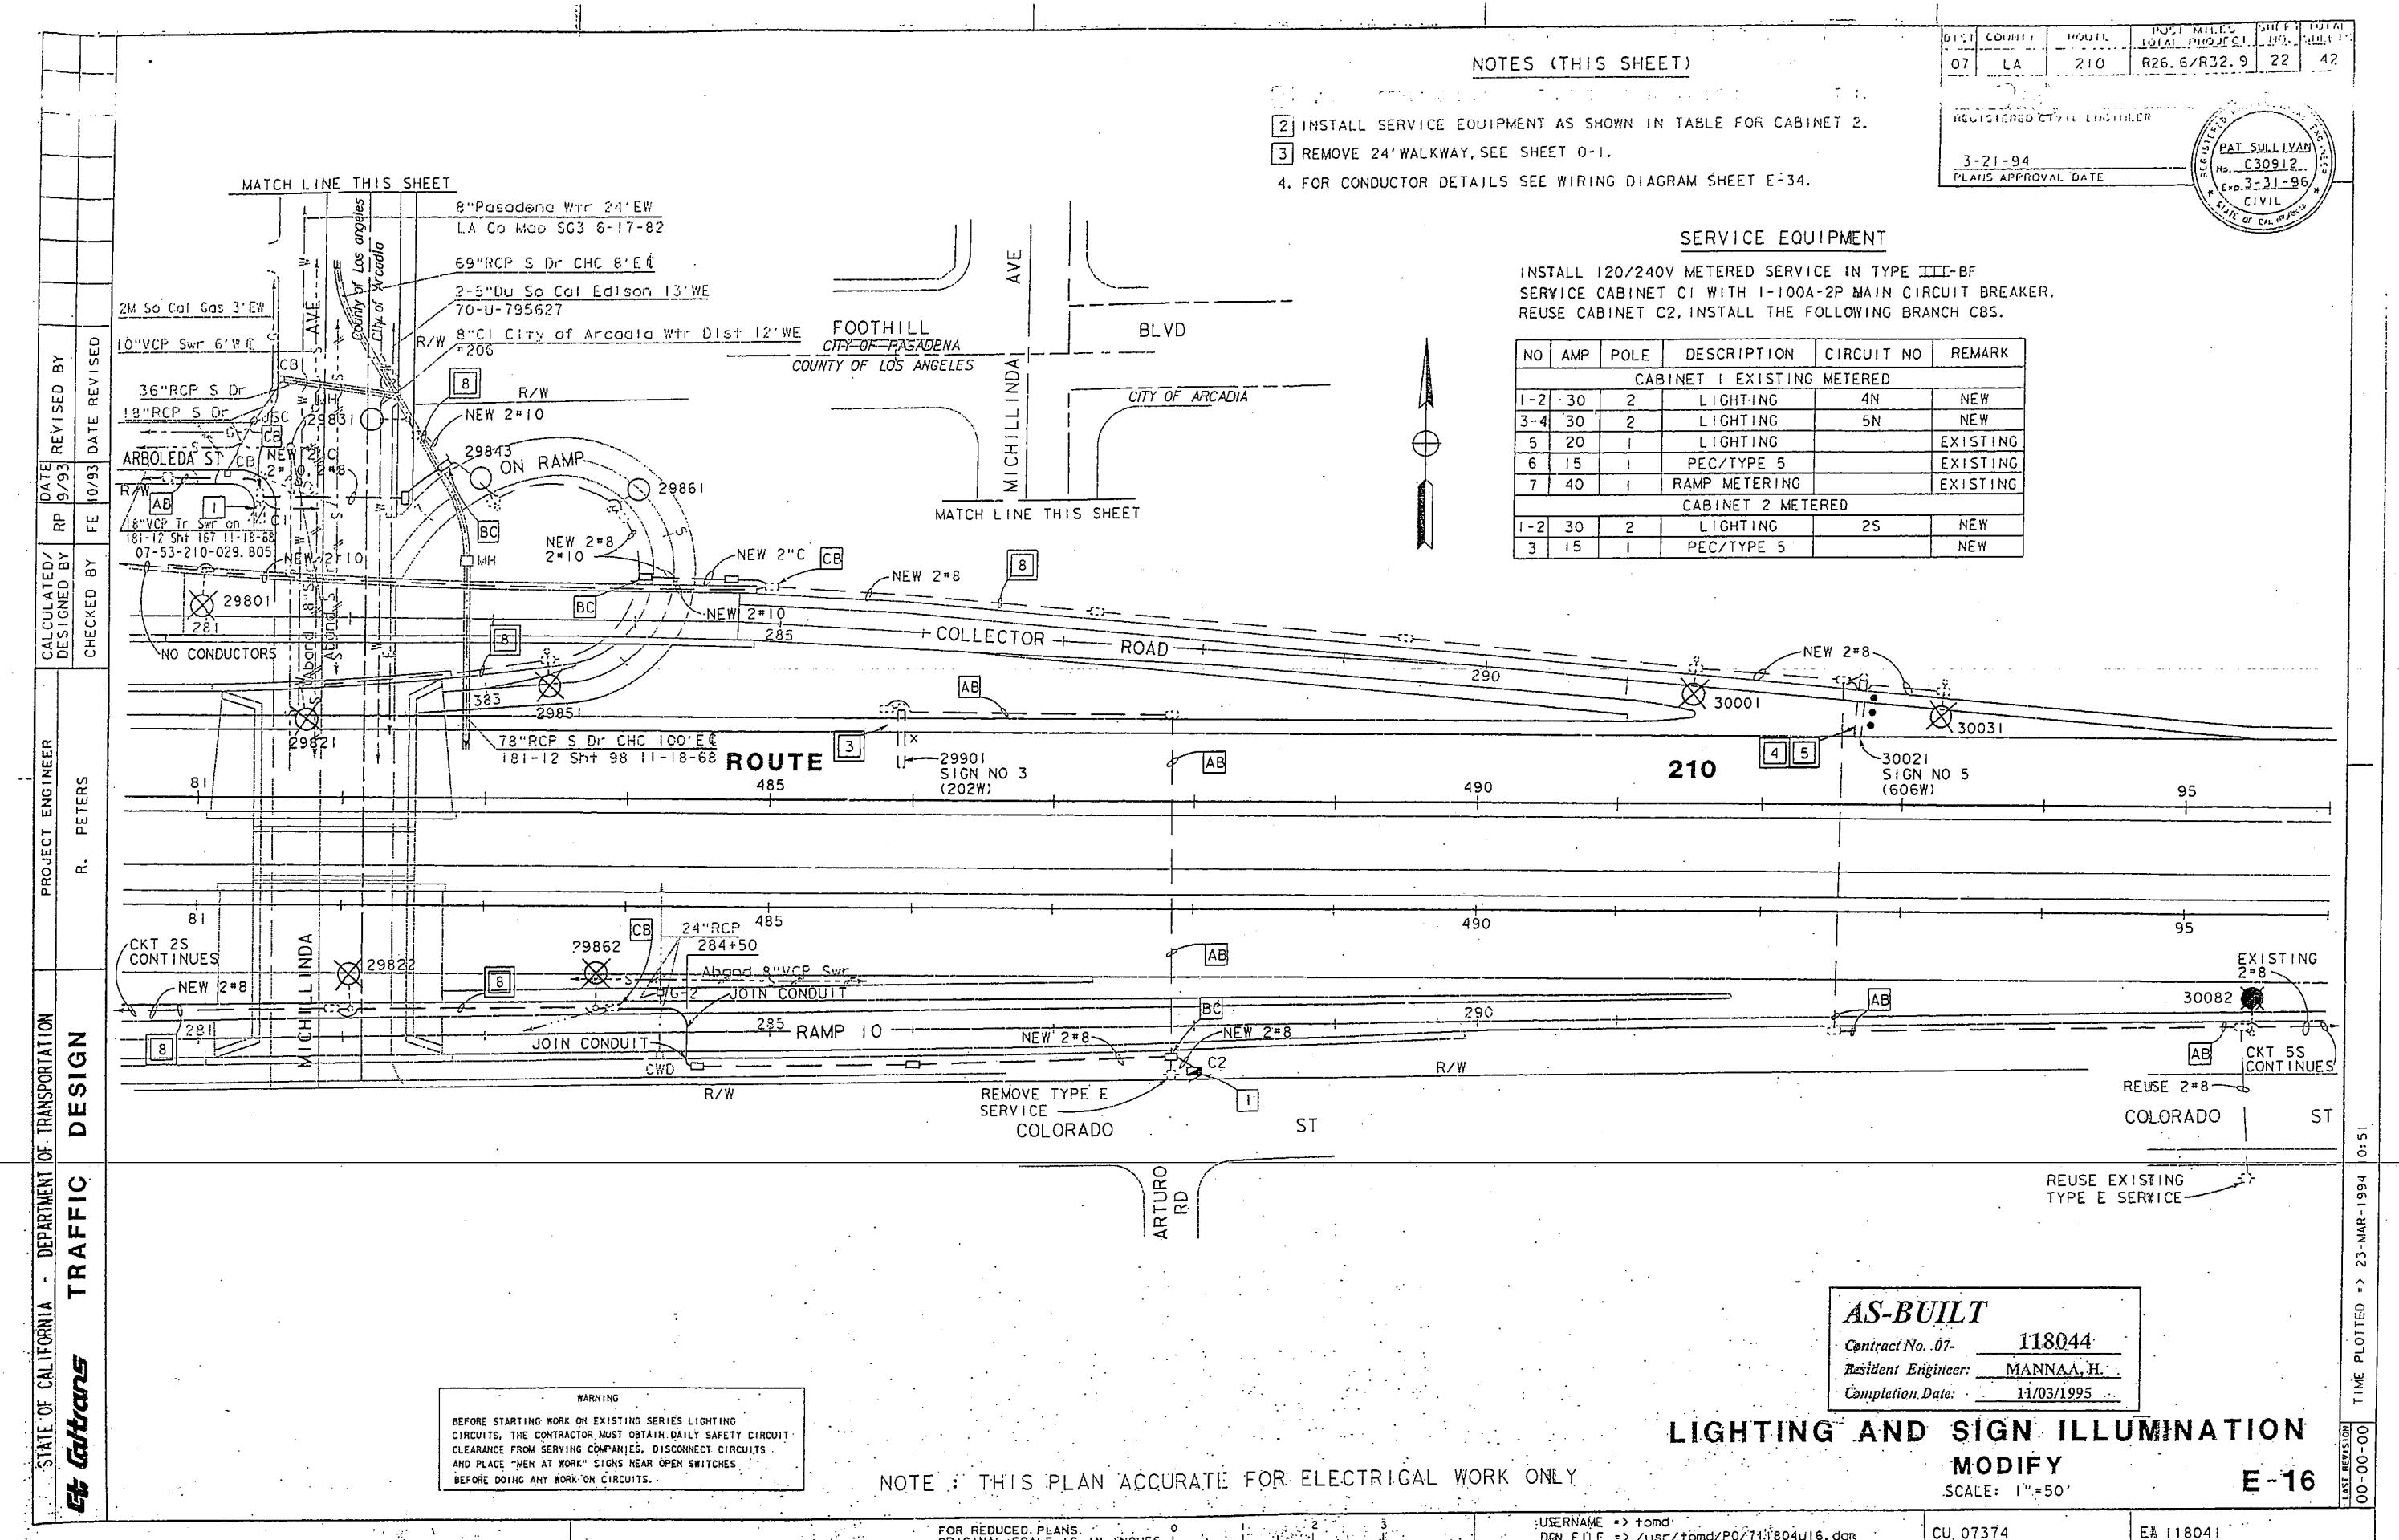


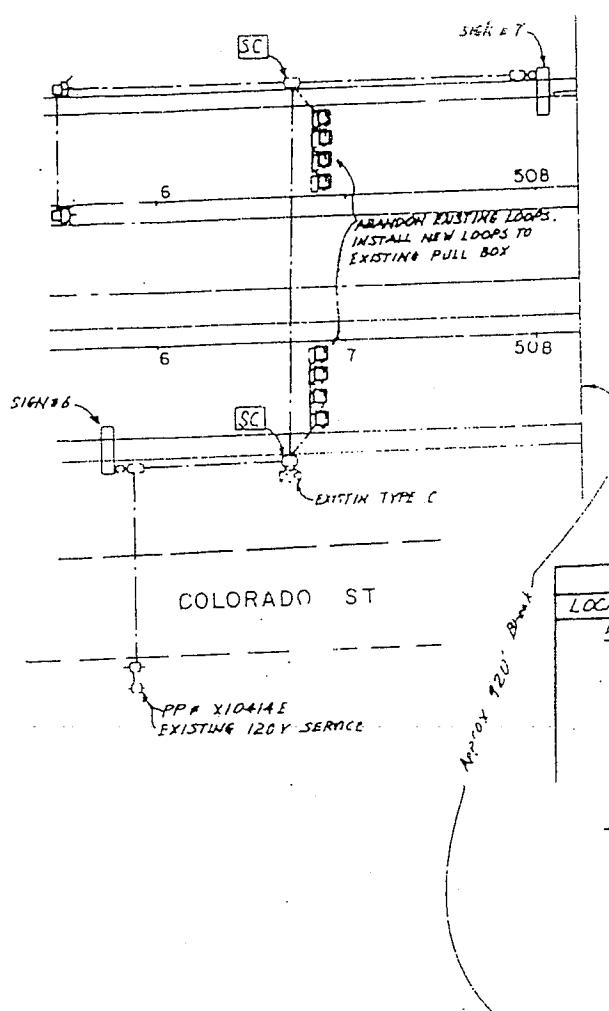

CONDUCTOR SCHEDULE							
LOCATION	AWG	CIRCUIT	A	A	A	A	M
5		COUNT DETECTOR	2	5	5	3	2
		DLC				2	
		DEMAND DETECTOR				1	
		PASSAGE DETECTOR			2		
		QUEUE DETECTION				2	
		SIGNAL	1	3	3		
		SETUP - ON			2	2	
		SPARE	3	3	3	3	
		SIGNAL COMMON	1	1		2	
		POWER SERVICE			2	1	2

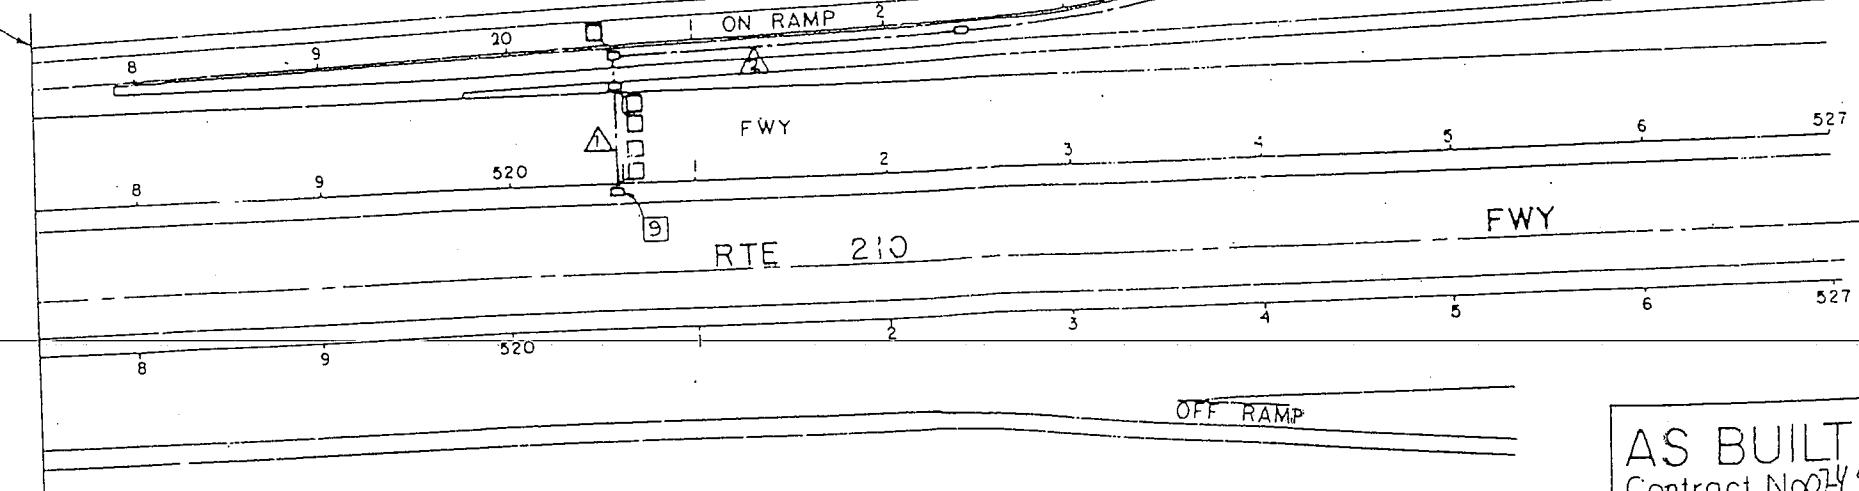

PPA 0783-210-BALDWIN
ID# 0783-210-BALDWIN
CBSC
INSTALL 6#8 & 2#12
ADD 2#8 & 2#12

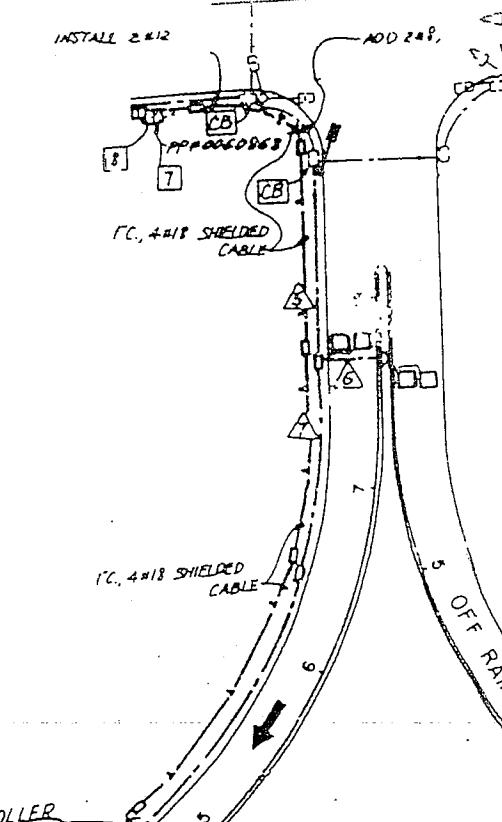

AS BUILT
CONTRACT NO. 07498304
RESIDENT ENGINEER: J. G. GIBSON
DATE: 09/09/88

RAMP METERING PLAN

RTE 210 FWY
AT

BALDWIN AVE/FOOTHILL BL

AS BUILT PLANS
Contract No. 07498304
Date Completed 09/09/88
Document No.


0 50 100 FEET

07351-498301

2 2 4

FOR PROJECT NOTES AND LEGEND SEE SHEET 1 OF ELECTRICAL PLANS

NOTE THIS PLAN ACCURATE FOR ELECTRICAL ONLY

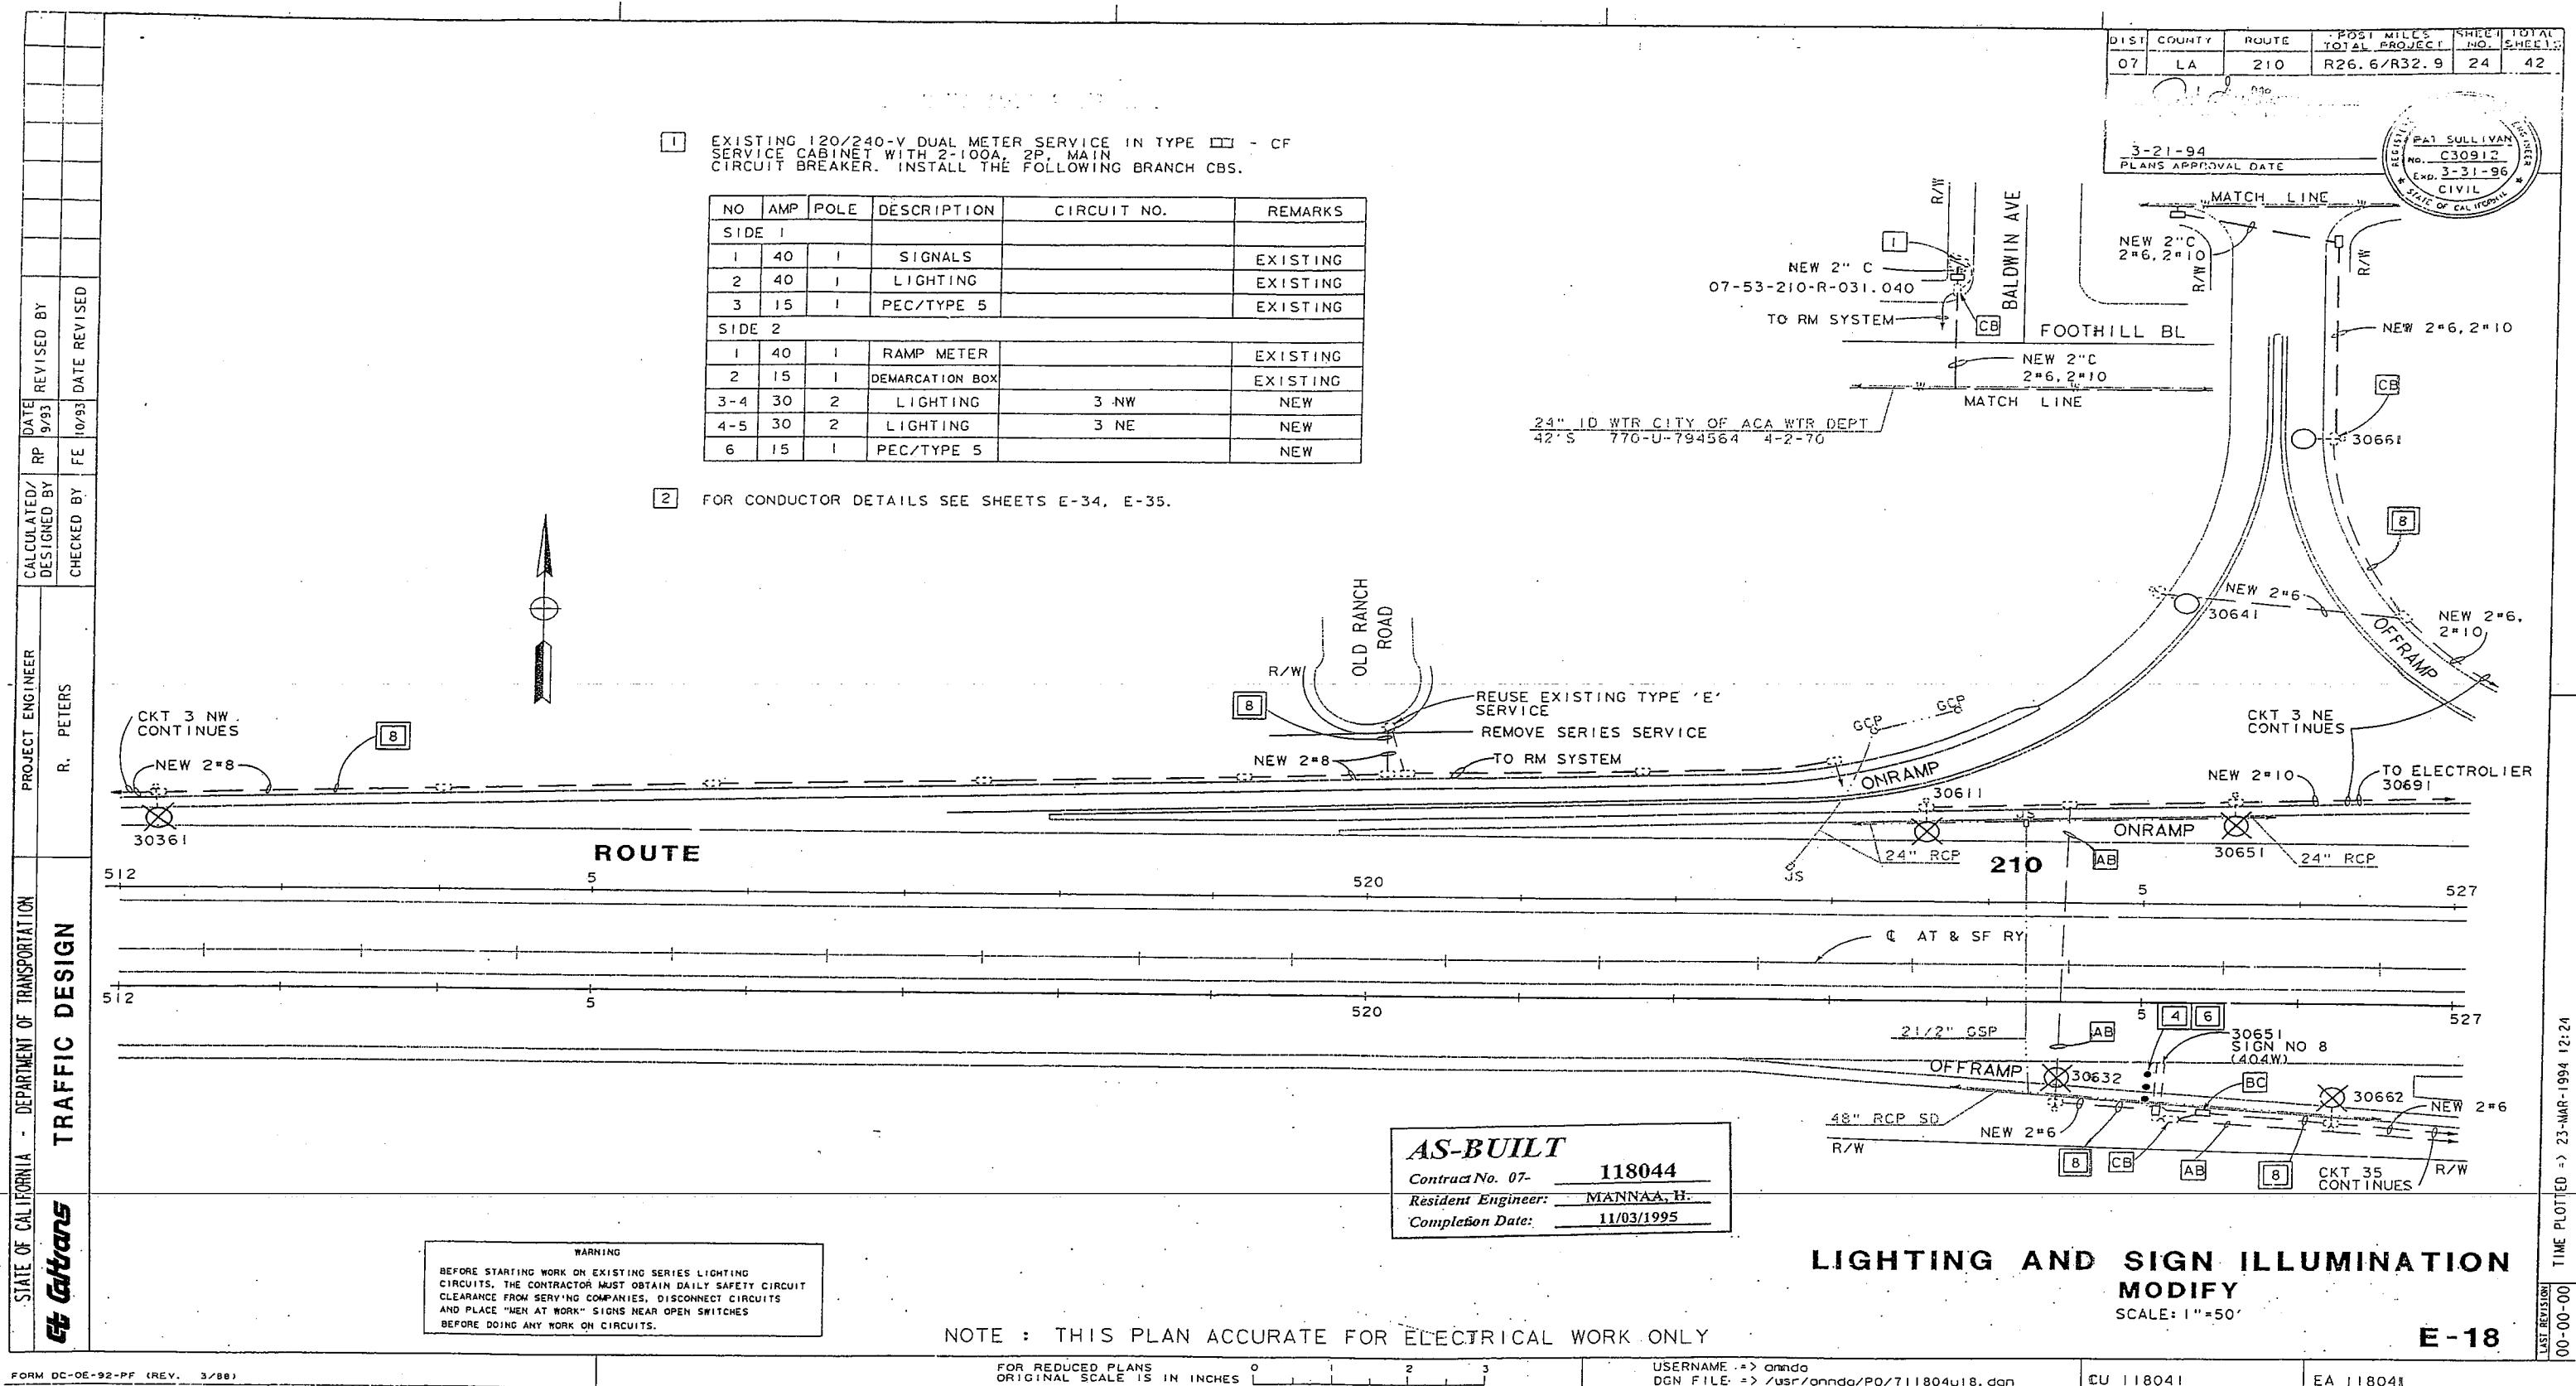

DIST	COUNTY	ROUTE	KILOMETER POST	SHEET NO.	TOTAL SHEETS
07	LA	210	R43.7/R74.8	116	163

PLANS APPROVAL DATE
9-18-06
EXPIRATION DATE
09/30/06
The State of California or its officers or agents shall not be responsible for the accuracy or completeness of electronic copies of this plan sheet.
To get to the Caltrans web site, go to <http://www.dot.ca.gov>

CH2M HILL
3 HUTTON CENTRE DRIVE, SUITE 200
SANTA ANA, CA 92707

CONDUIT AND CONDUCTOR SCHEDULE									
EWC CP	FUNCTION	CONDUIT RUN							
		1	2	1	1	2(E)	2(E)	2(E)	2(E)
9CSC	RAMP SIGNAL								
5CSC	METER-ON			1	1				
#8	RM CONTROLLER SERVICE			2(E)	2(E)	2(E)	2(E)		
DLC	COUNT DETECTOR	1	1	1				1	
	DEMAND DETECTOR			1	2			2	
	PASSAGE DETECTOR			1	2			2	
	QUEUE DETECTOR				2	2		2	
4#18	SURVEILLANCE DETECTOR	2	5	5	5		5		
	TELEPHONE CABLE						1(E)		
CONDUIT SIZE		53 (E)	53 (E)	53 (E)	53 (E)	78	53 (E)	53 (E)	2-78 (E)

CALCULATED BY ALEX ZUPANSKI
DESIGNED BY KEENE M MATSUDA
CHECKED BY



DESIGN OVERSIGHT CECILIO BURCIAGA

STATE OF CALIFORNIA - DEPARTMENT OF TRANSPORTATION



PROJECT NOTES: (THIS SHEET ONLY)

- 1 INSTALL TYPE I-A SIGNAL STANDARD PER DETAIL A ON SHEET E-41. LOCATE 1.2 m FROM ES.
- 2 INSTALL NEW 53C TERMINATION CONDUIT.
- 3 RC EXISTING LOOP LEAD-IN CABLES, RAMP METER CABLES, AND METER-ON CABLES TO CONTROLLER CABINET. INSTALL NEW DLC AND CSC PER CONDUIT AND CONDUCTOR SCHEDULE.
- 4 RS EXISTING SIGNAL HEADS AND MOUNTINGS. INSTALL NEW SIGNAL HEADS AND MOUNTINGS ON EXISTING SIGNAL STANDARD PER DETAIL A ON SHEET E-41.

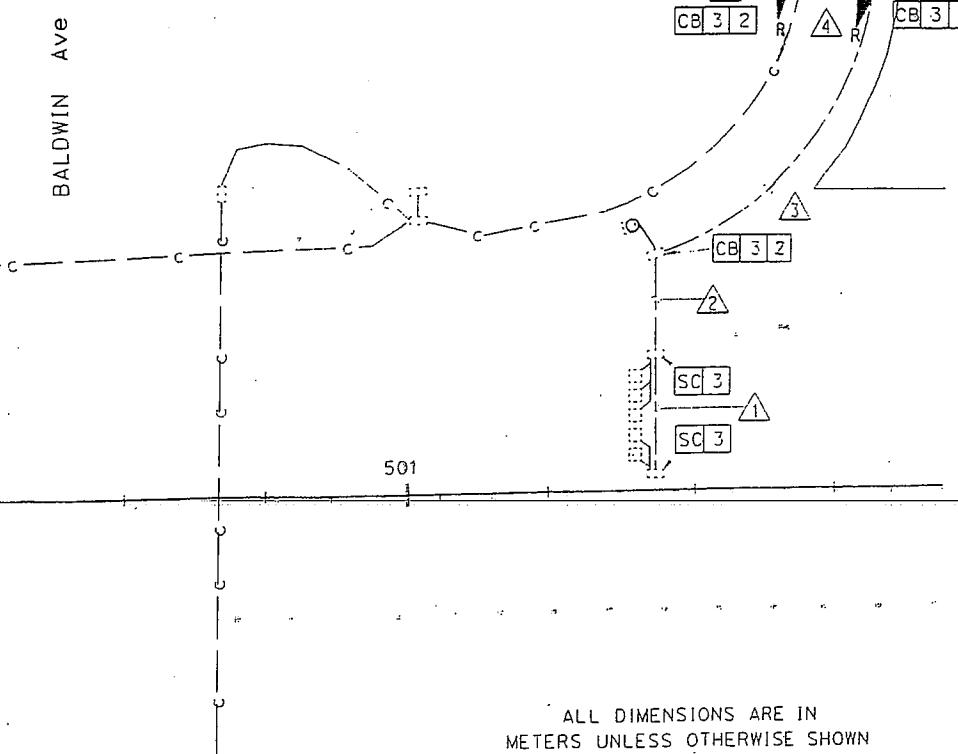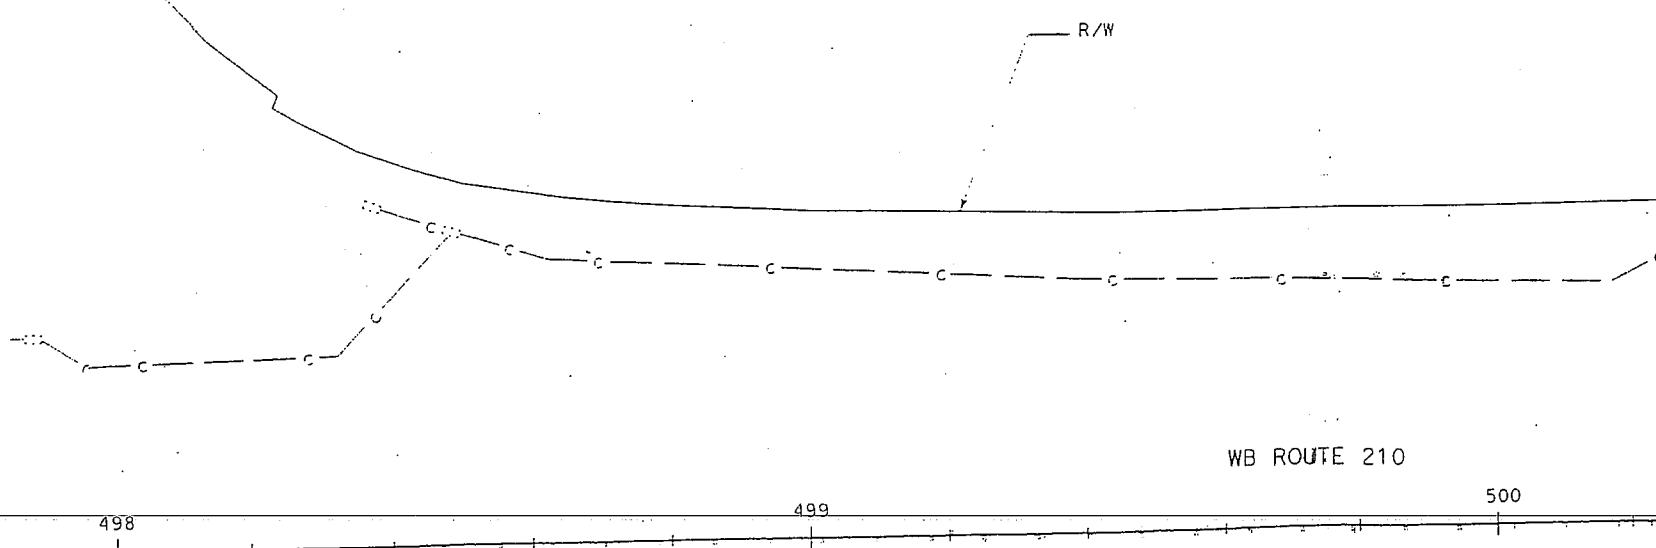

THIS PLAN ACCURATE FOR ELECTRICAL WORK ONLY.
FOR COMPLETE EIGHT OF ALL INFORMATION ASK FOR DATA.
FOR EIGHT OF THE PLAN AT CAL TRANS.

RELATIVE BORDER SCALE
IS IN MILLIMETERS

MAPNAME = 107023
FILE # = 105149011.PDF

CU 07383

EA 257401

Parcations 11

DIST	COUNTY	ROUTE	POST MILES	ROUTE NO.	INITIAL
			PROJECT	NO.	NUMBER
07	LA	210	R26.6/R32.9	25	42


NOTES (THIS SHEET)

SERVICE FOR IRRIGATION AND RAMP METER.
INSTALL BRANCH CBS AS NOTED.

NO	AMP	POLE	DESCRIPTION	CIRCUIT NO	REMARK
1	20	1	IRRIGATION		EXISTING
2	40	1	RAMP METER	RM	EXISTING
3	15	1	DEMARCATION BOX		EXISTING
4-5	30	2	LIGHTING	6N	NEW
6	15	1	PEC/TYPE 5		NEW

- 2** INSTALL 120/240V TYPE 111-BF METERED SERVICE WUTH 1-100A, 2P MAIN CB.
1-30A, 120V, IP CB. 1-15A, 120V, IP FOR PEC/TYPE 5.

3. FOR CONDUCTOR DETAILS SEE
WIRING DIAGRAM SHEET E-35.

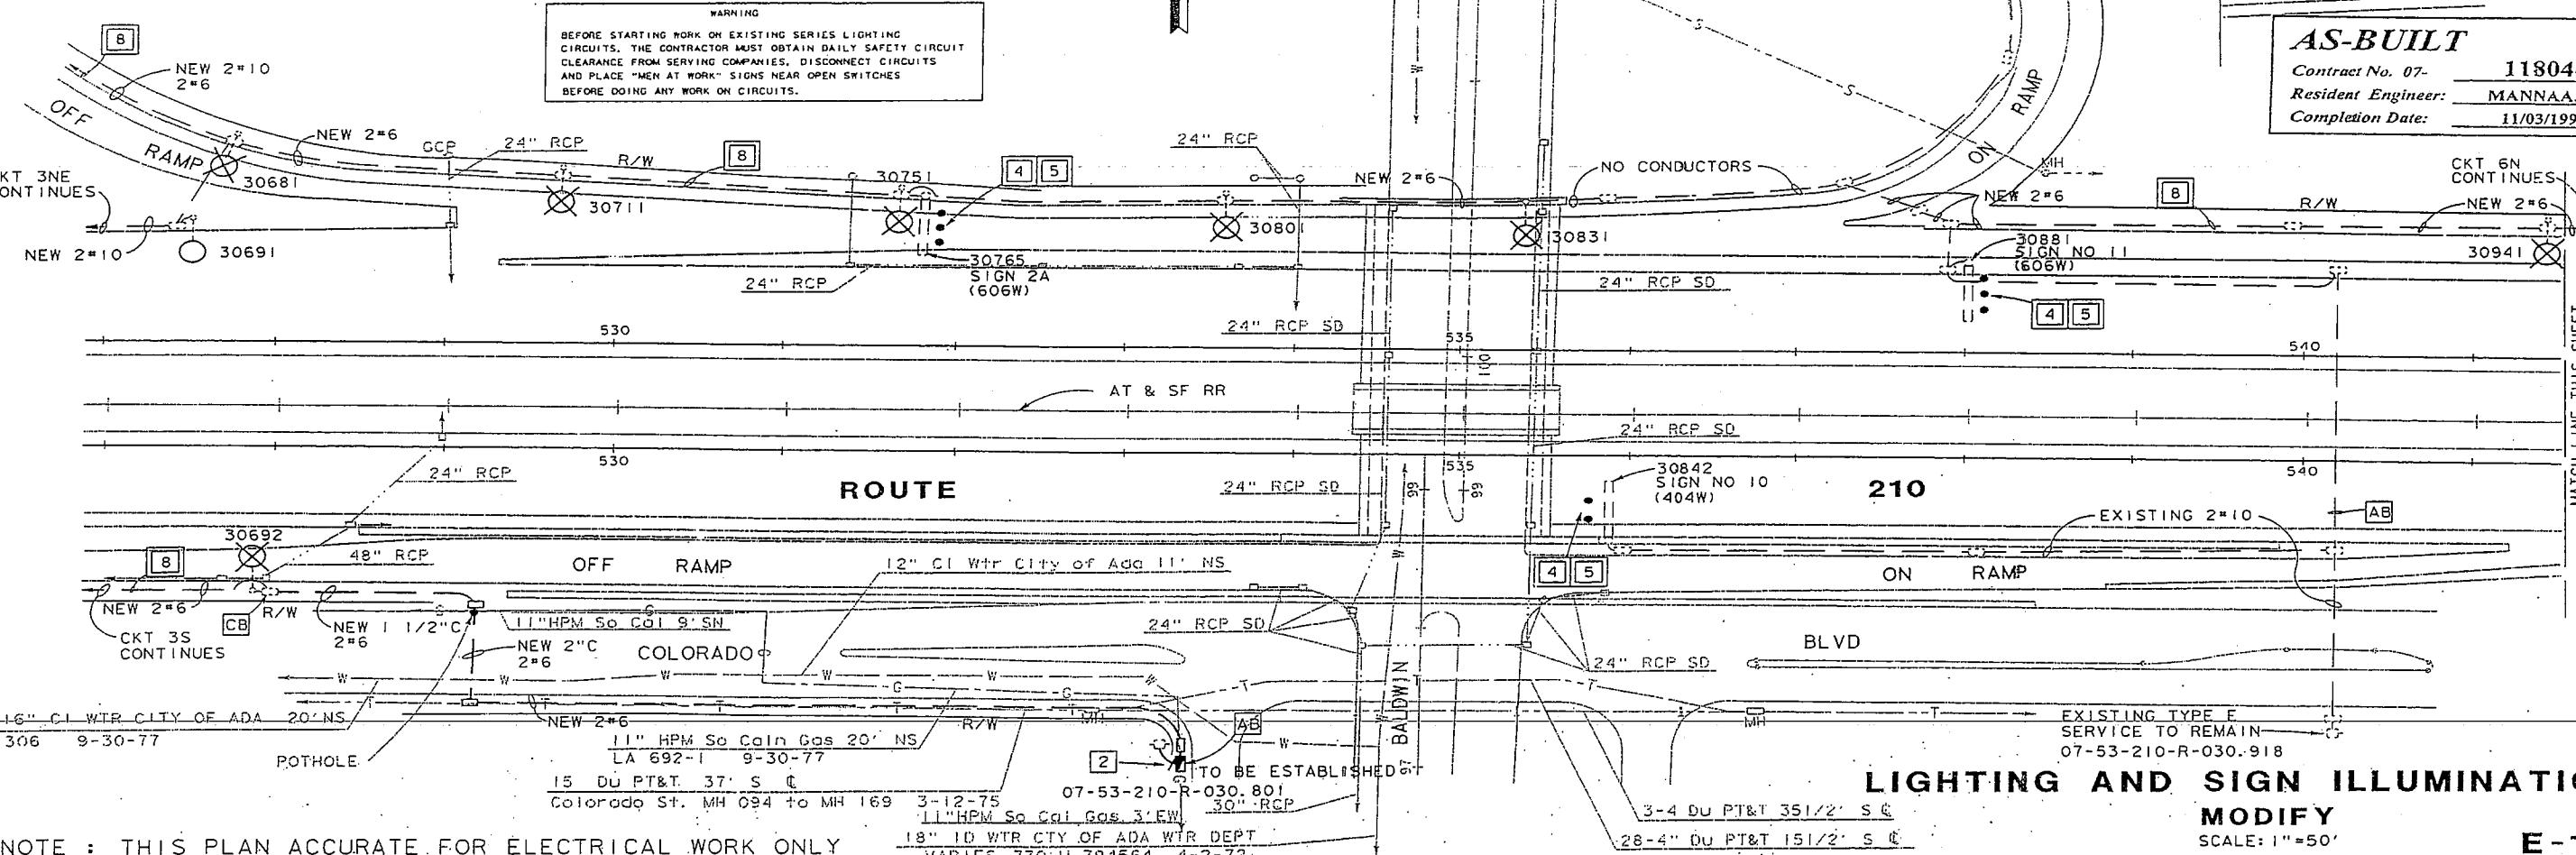

R. PETERS

TRAFFIC DESIGN

The Cutters

NOTE : THIS PLAN ACCURATE FOR ELECTRICAL WORK ONLY

FORM PC-9E-92-PF (REV. 3/88)

FOR REDUCED PLANS 0 1 2
ORIGINAL SCALE IS IN INCHES | | | | |


USERNAME => annda
DGN FILE => /usr/annda/PO/711804u19.dgn

CH 07374

EA-118041

E - 19

TIME PLOTTED => 23-MAR-1994 12:24

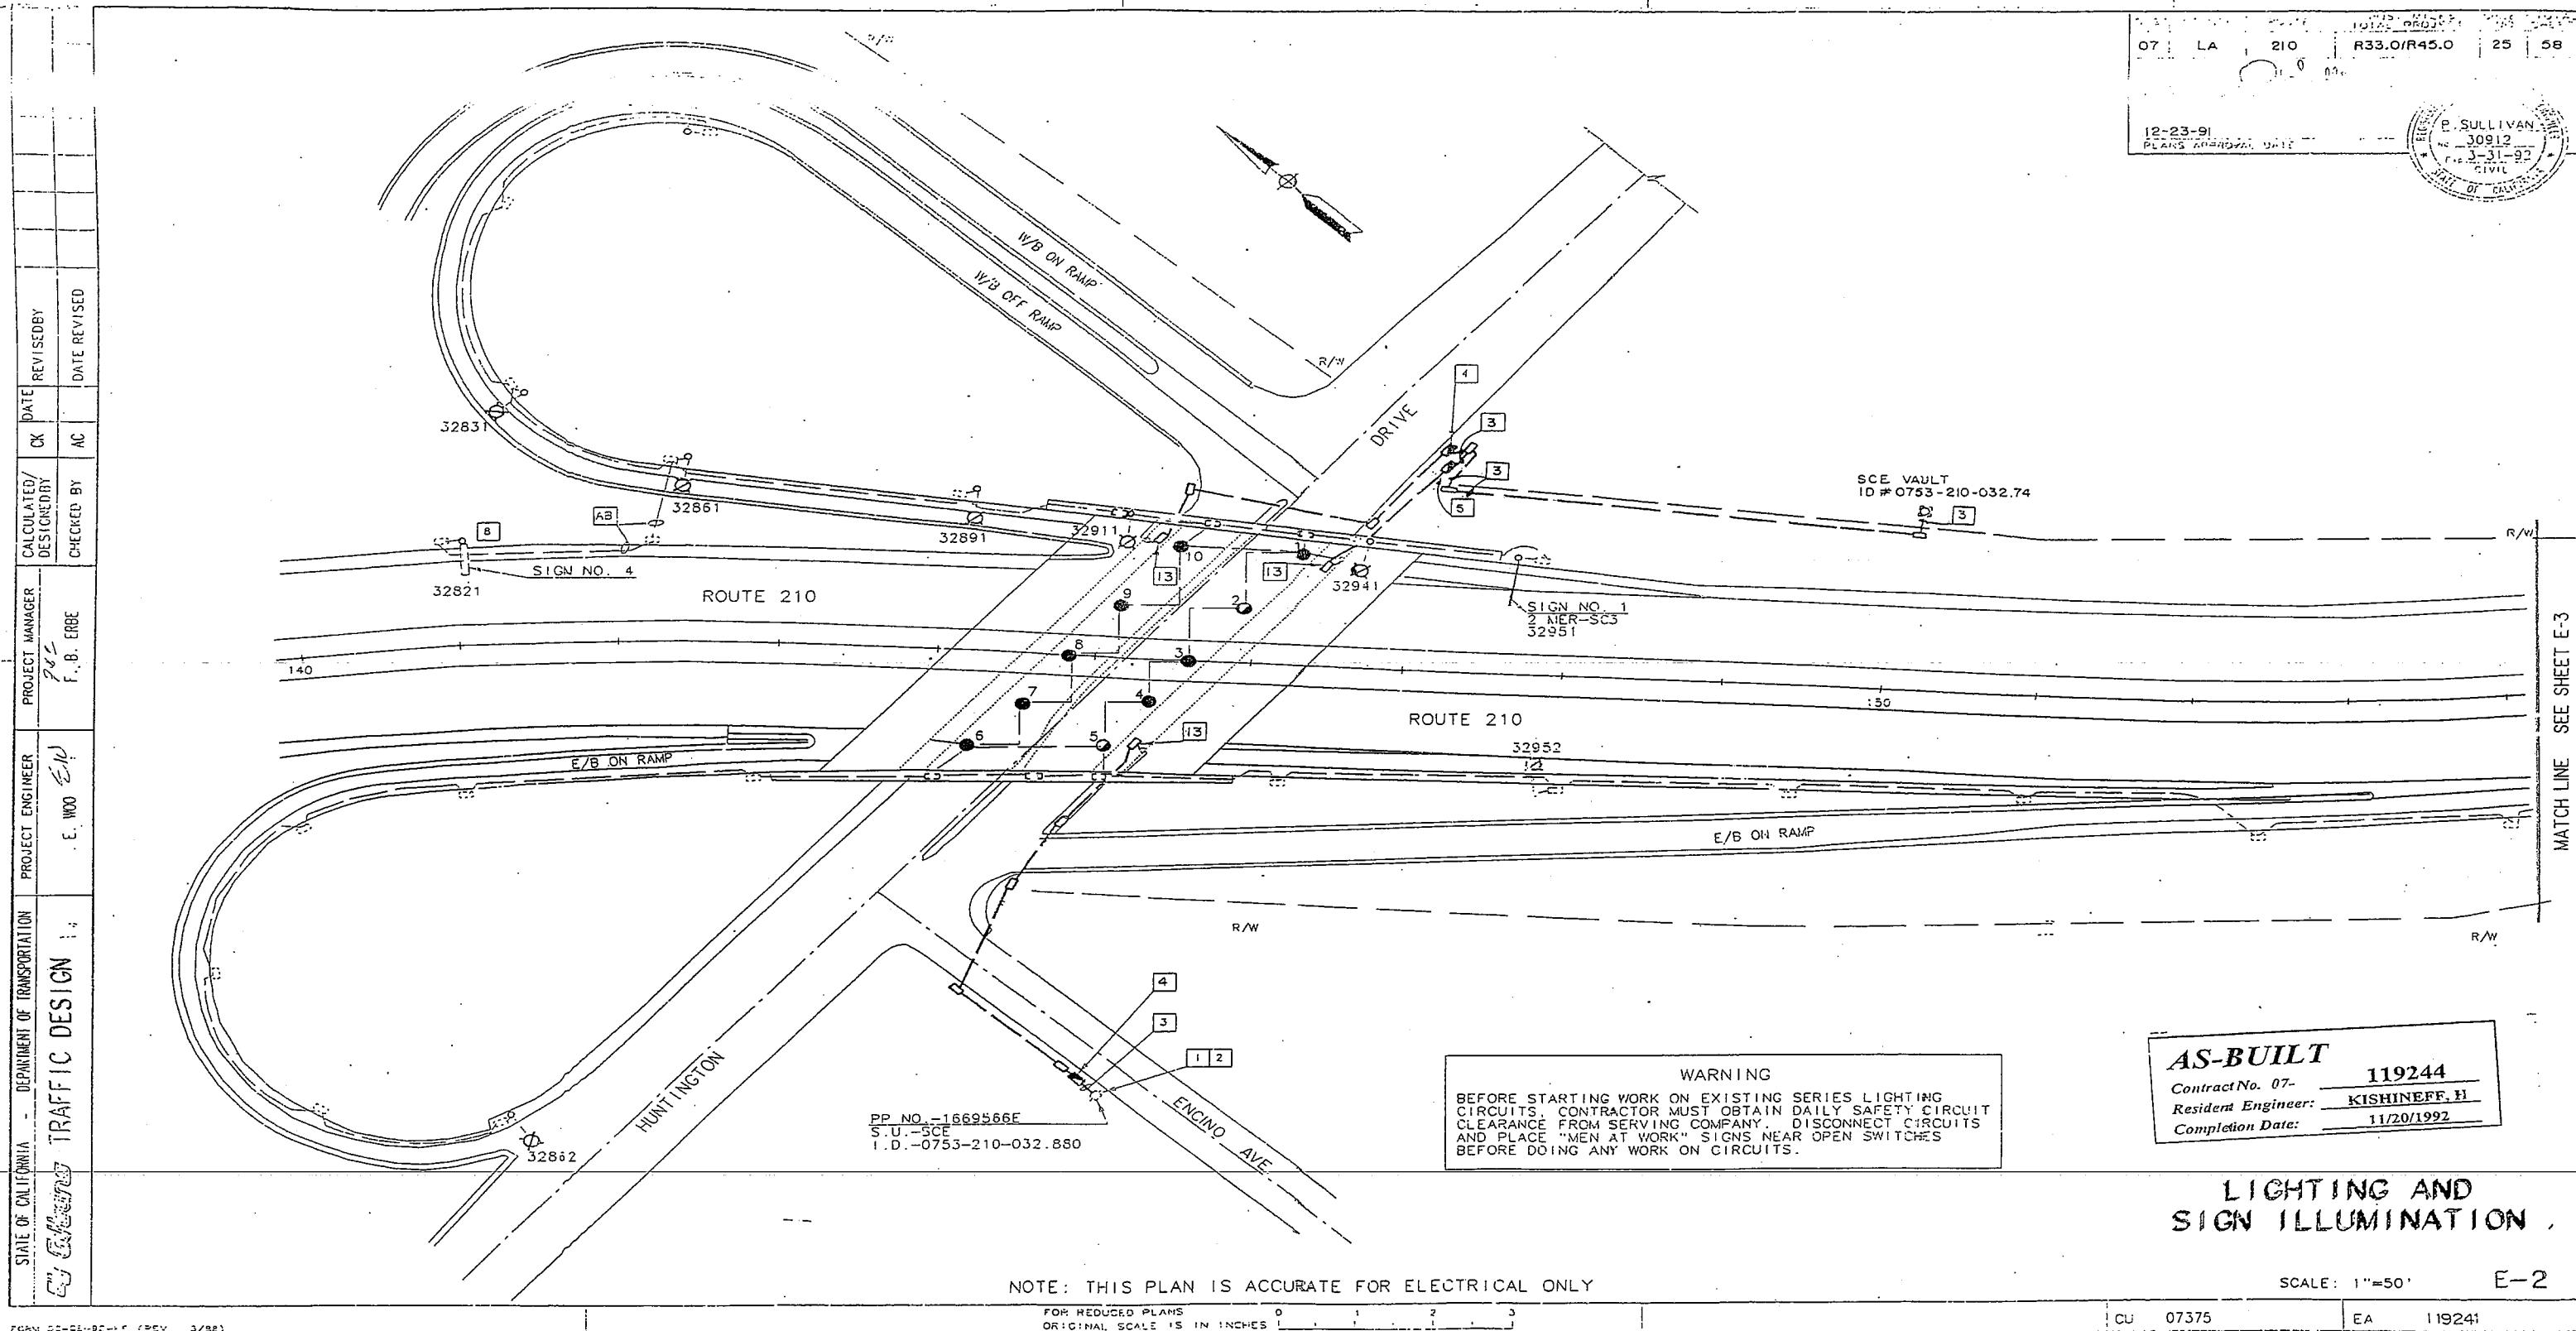

Location 12
13

STATE OF CALIFORNIA - DEPARTMENT OF TRANSPORTATION	CONSULTANT FUNCTIONAL SUPERVISOR ALEXANDER ZUPANSKI	CALCULATED-DESIGNED BY CHECKED BY	HENRY TRINH ALEXANDER ZUPANSKI
--	--	--------------------------------------	-----------------------------------

NOTE:
FOR COMPLETE RIGGHT OF WAY AND ACCURATE ACCESS DATA,
SEE RIGHT OF WAY RECORD MAPS AT DISTRICT OFFICE

AWG	FUNCTION	1	2	3	4	5	6
#6	LIGHTING	2	2	2	2		
	SIGN ILLUMINATION	2	2	2	2		
	GROUND	1	1	1	1	1	1
#10	IRRIGATION						2
3CSC		1	1	1		1	
CONDUIT SIZE:		1½"(E)	3"	2"	2"	2"	2"



(E) = EXISTING

CONDUIT AND CONDUCTOR SCHEDULE


120/240 V TYPE III-BF
SERVICE EQUIPMENT ENCLOSURE
ID No. 07-53-210-R-033.500

Dist	COUNTY	ROUTE	POST MILES TOTAL PROJECT	Sheet No.	Total Sheets
07	LA	210	R31.8/R34.2		


Daniel TIAN
5/18/08
REGISTRATION NO. 12842
PLANS APPROVAL DATE
THE STATE OF CALIFORNIA OR ITS OFFICERS
OR AGENTS SHALL NOT BE RESPONSIBLE FOR
THE ACCURACY OR COMPLETENESS OF ELECTRONIC
COPIES OF THIS PLAN SHEET.
FPL AND ASSOCIATES, INC. PARSONS
10 CORPORATE PARK, SUITE 310 100 W WALNUT STREET
IRVINE, CA 92606 PASADENA, CA 91124

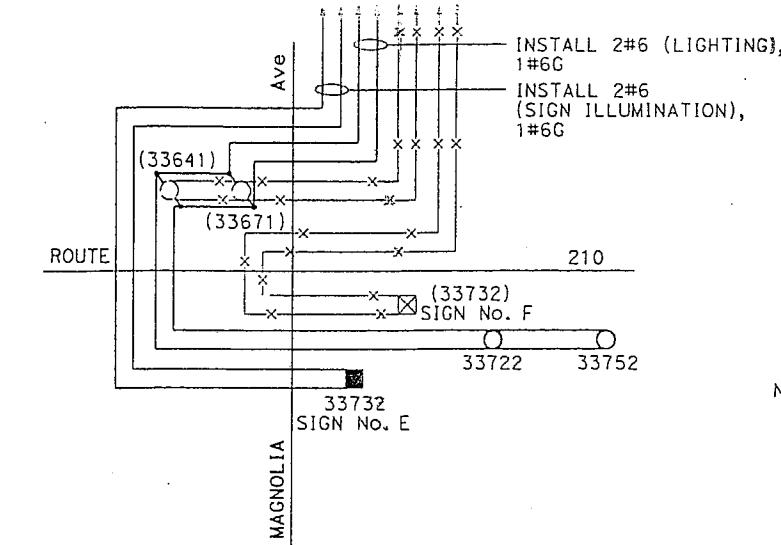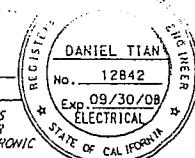

WIRING DIAGRAM
NTS

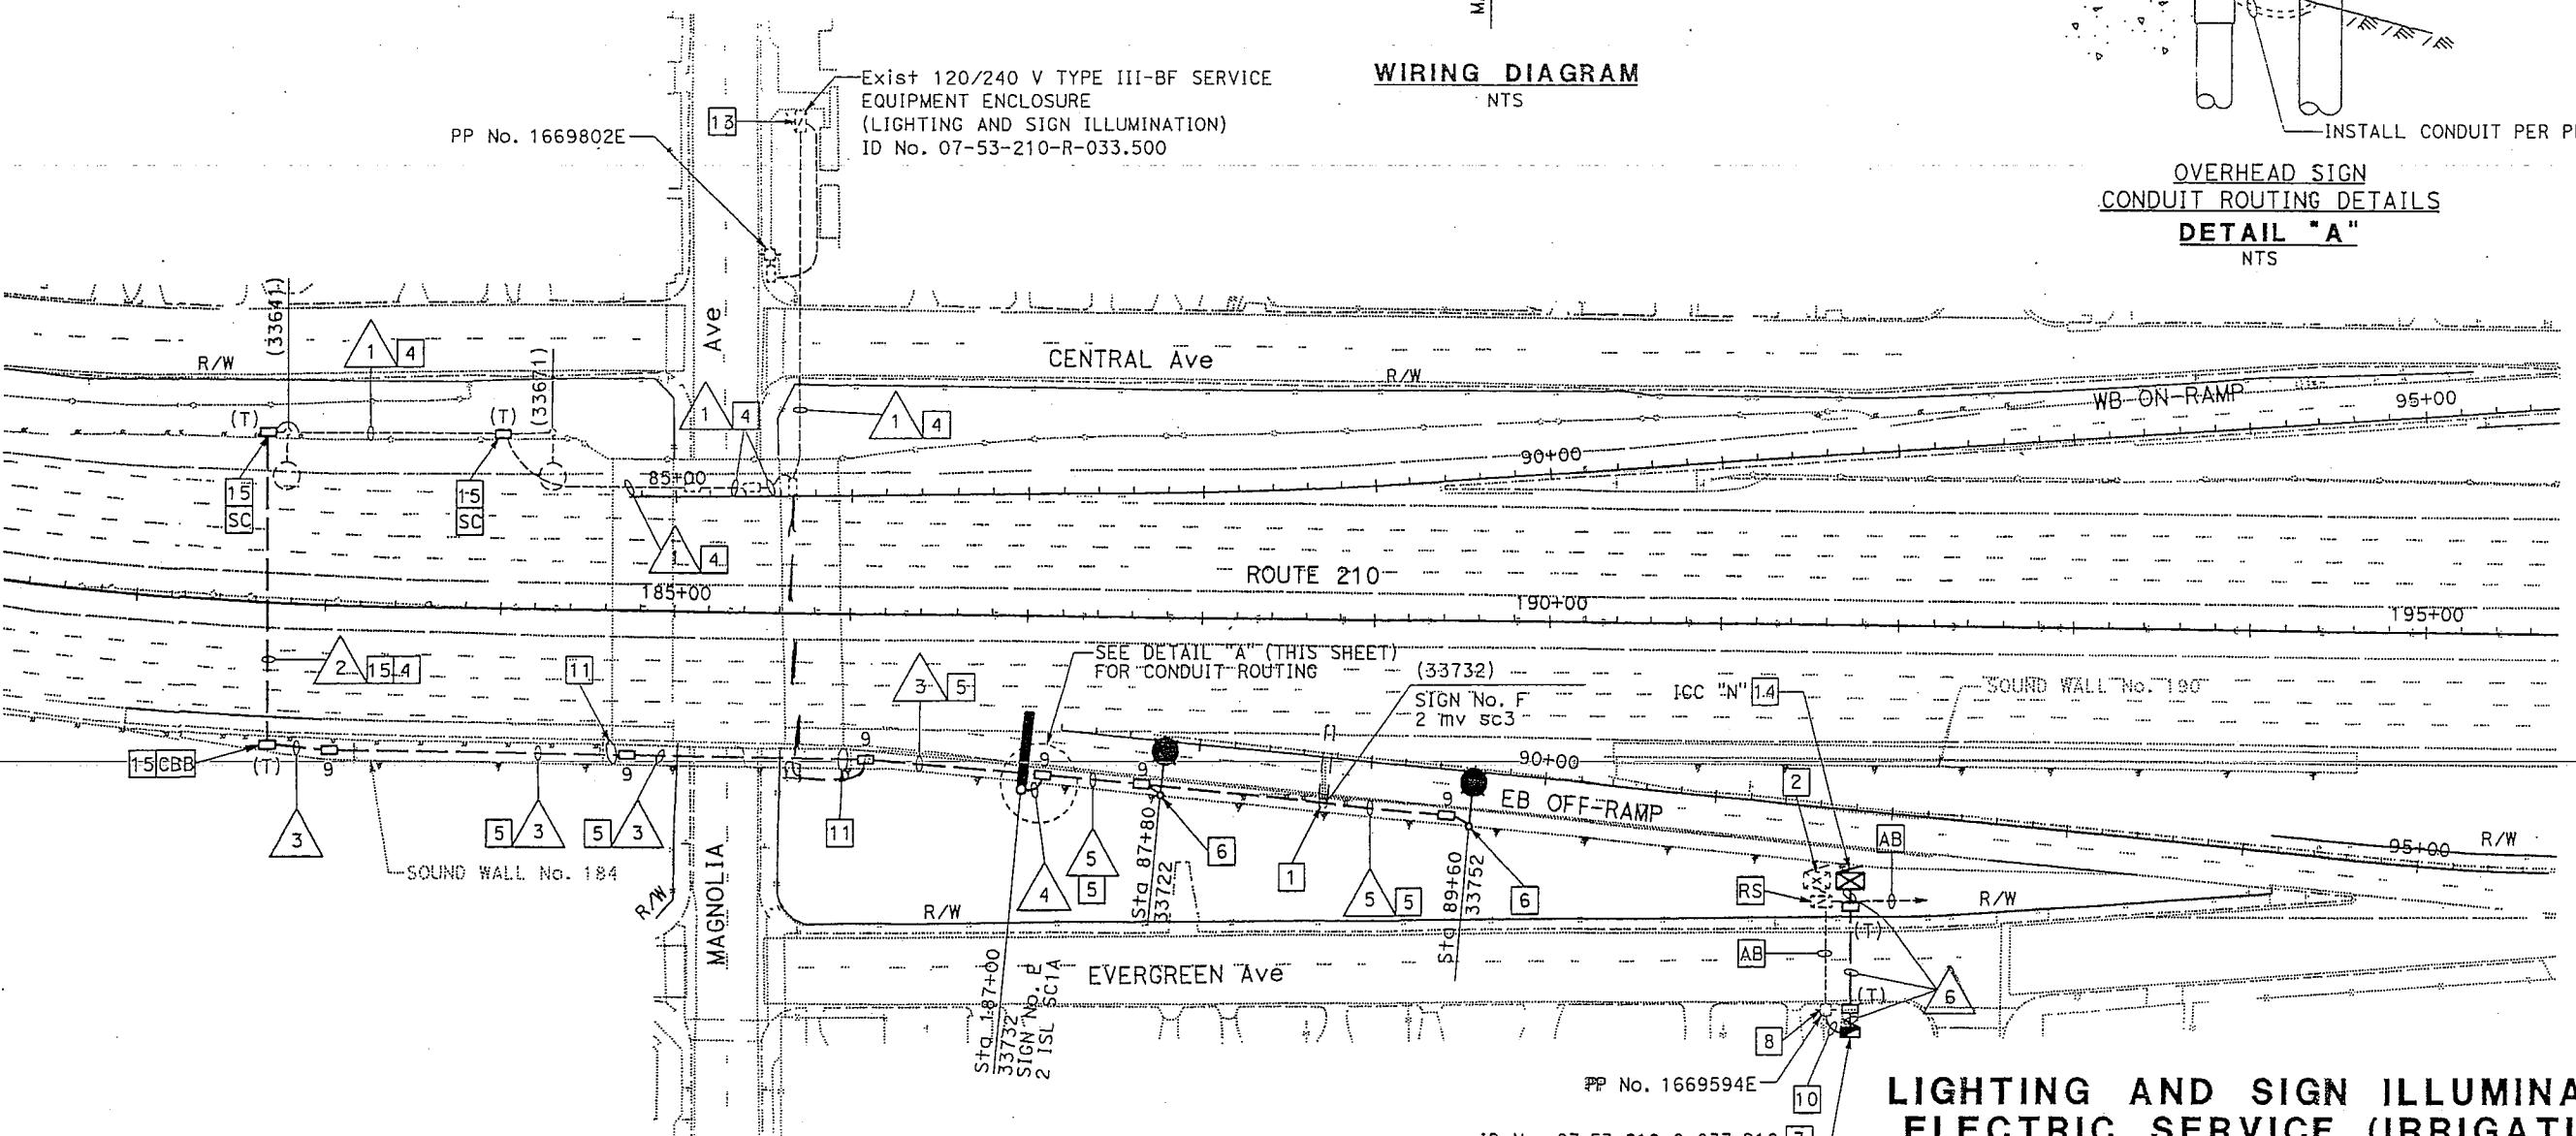

STATE OF CALIFORNIA	DEPARTMENT OF TRANSPORTATION	PROJECT ENGINEER	PROJECT MANAGER	CALCULATED/ DESIGNED BY	CK	DATE	REVISION BY
TRAFFIC DESIGN		E. WOO	F. B. ERBE	CHECHED BY	AC		DATE REV. SER.

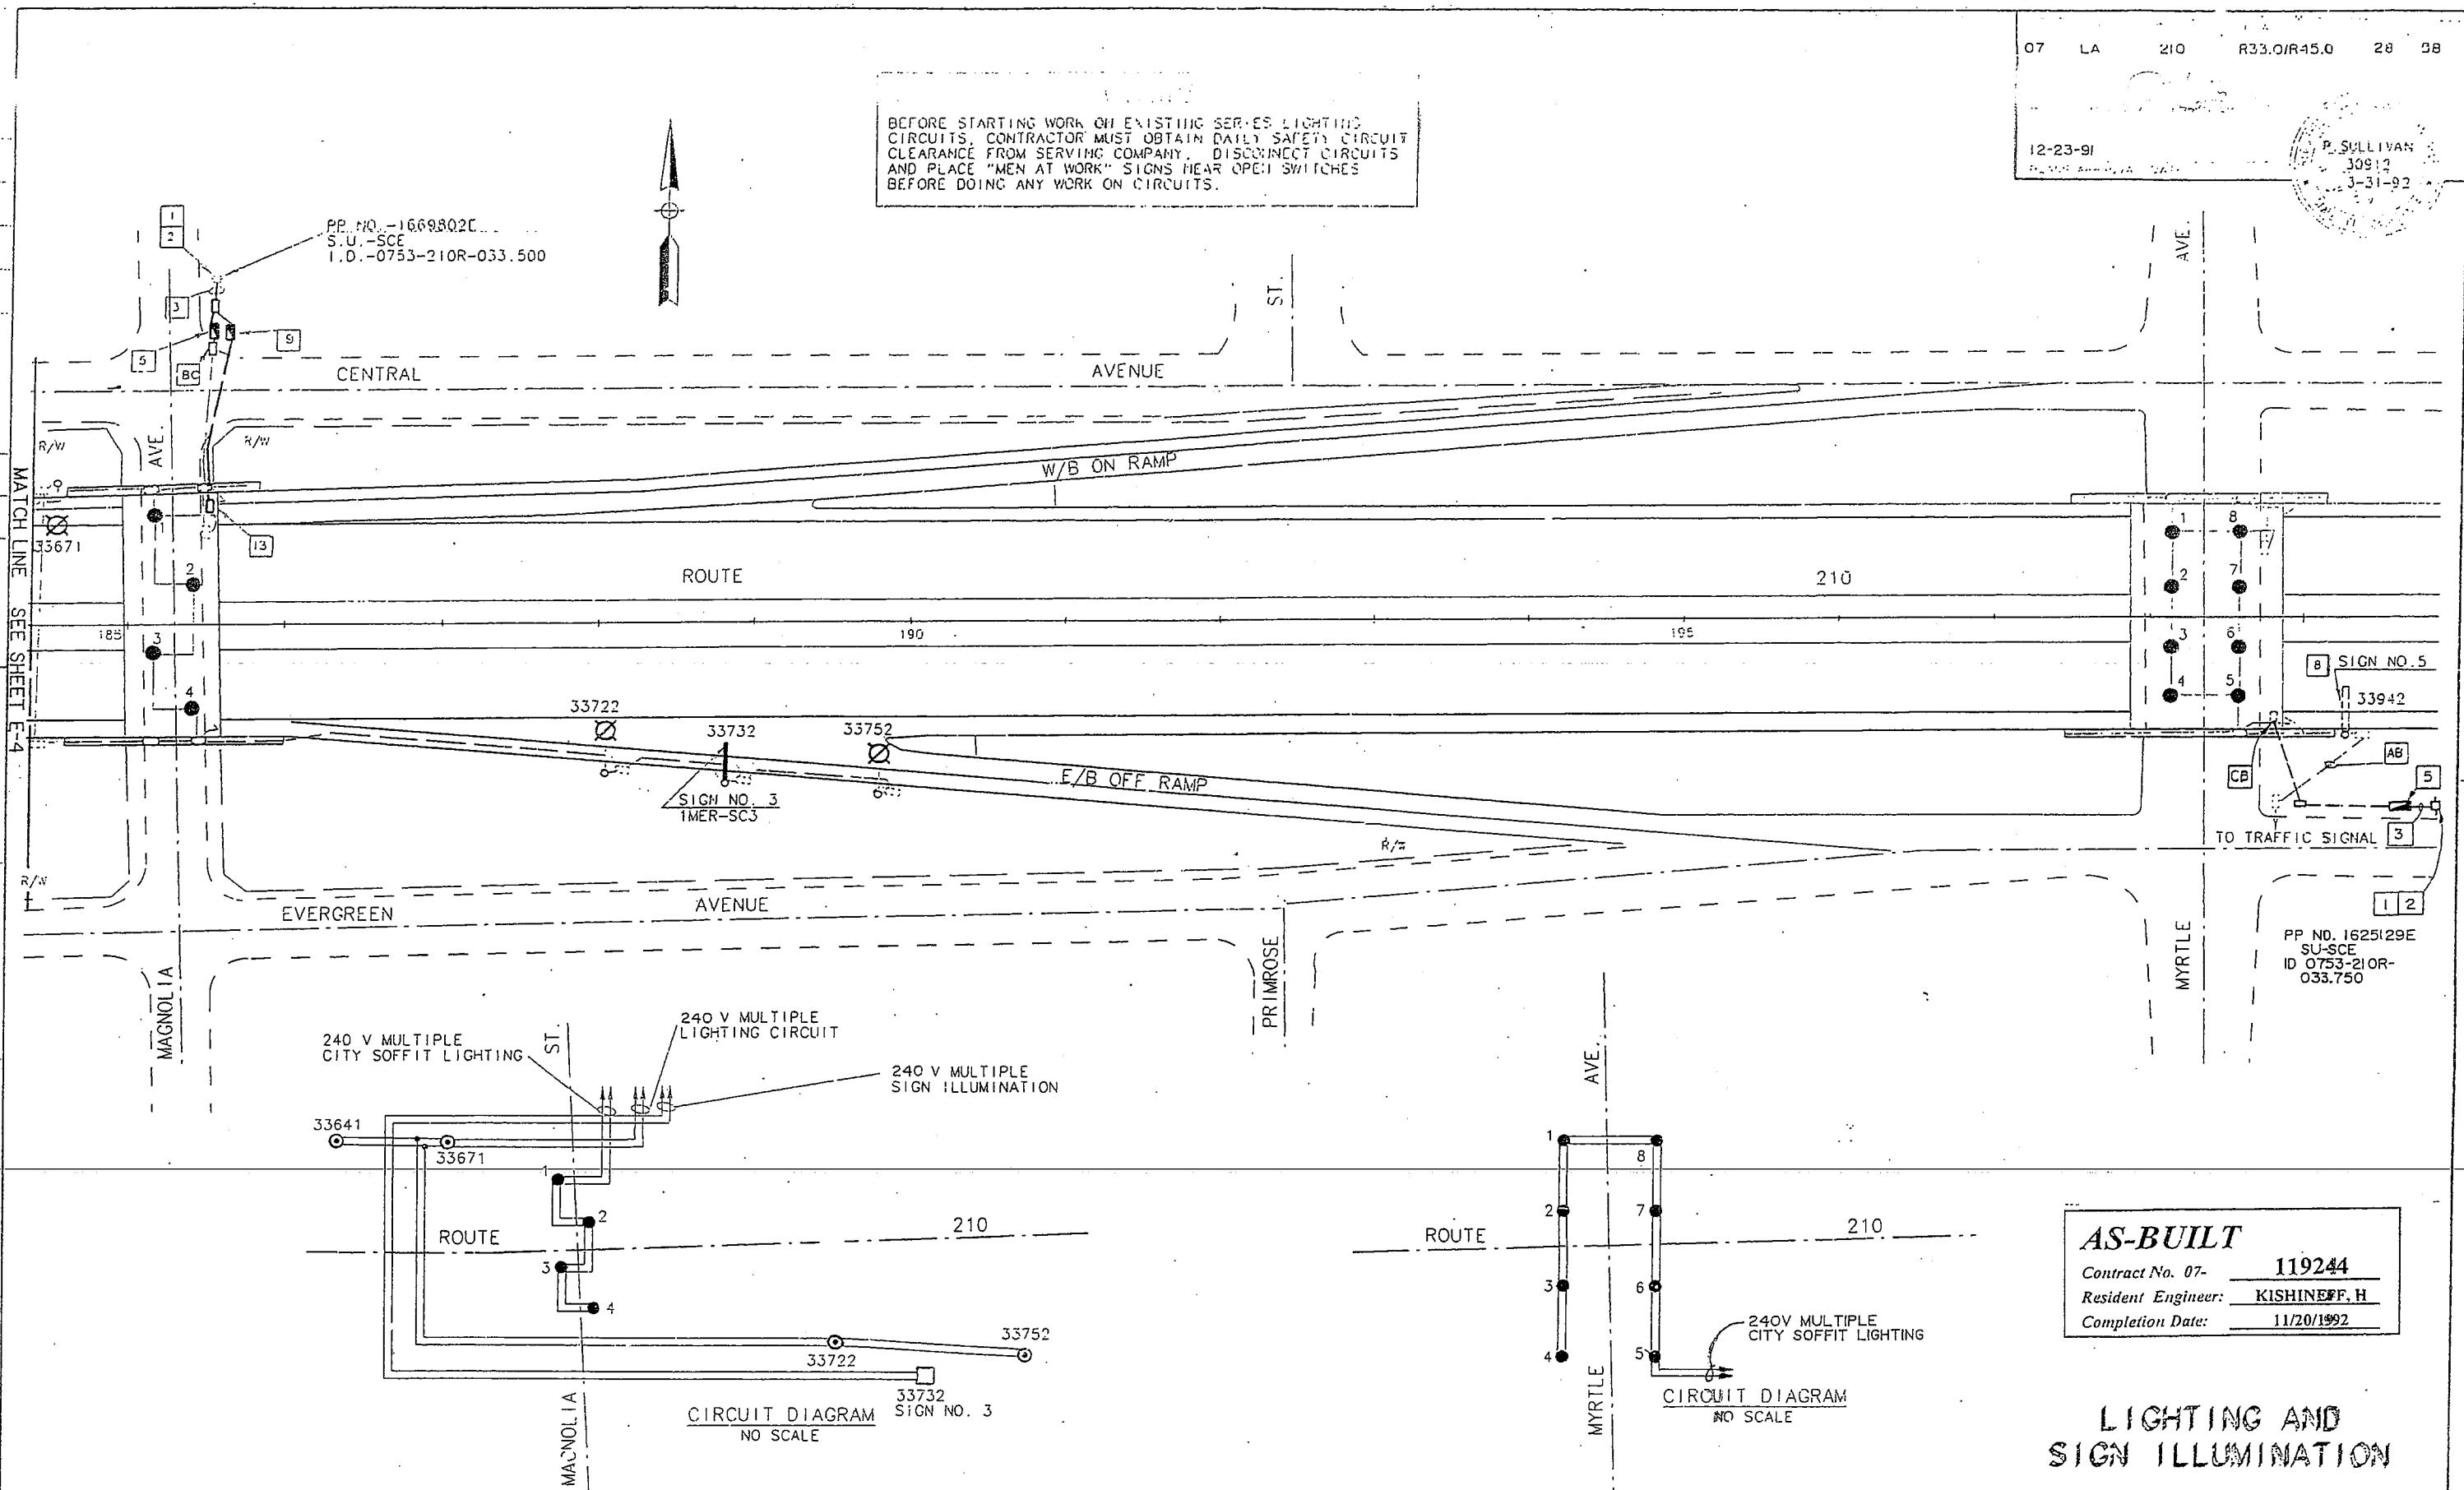

NOTE: THIS PLAN IS ACCURATE FOR ELECTRICAL ONLY

AS-BUILT

Contract No. 07- 119244


Resident Engineer: KISHINEFF, H.

Completion Date: 11/20/1992

LIGHTING AND SIGN ILLUMINATION

SCALE: 1"=50'

15

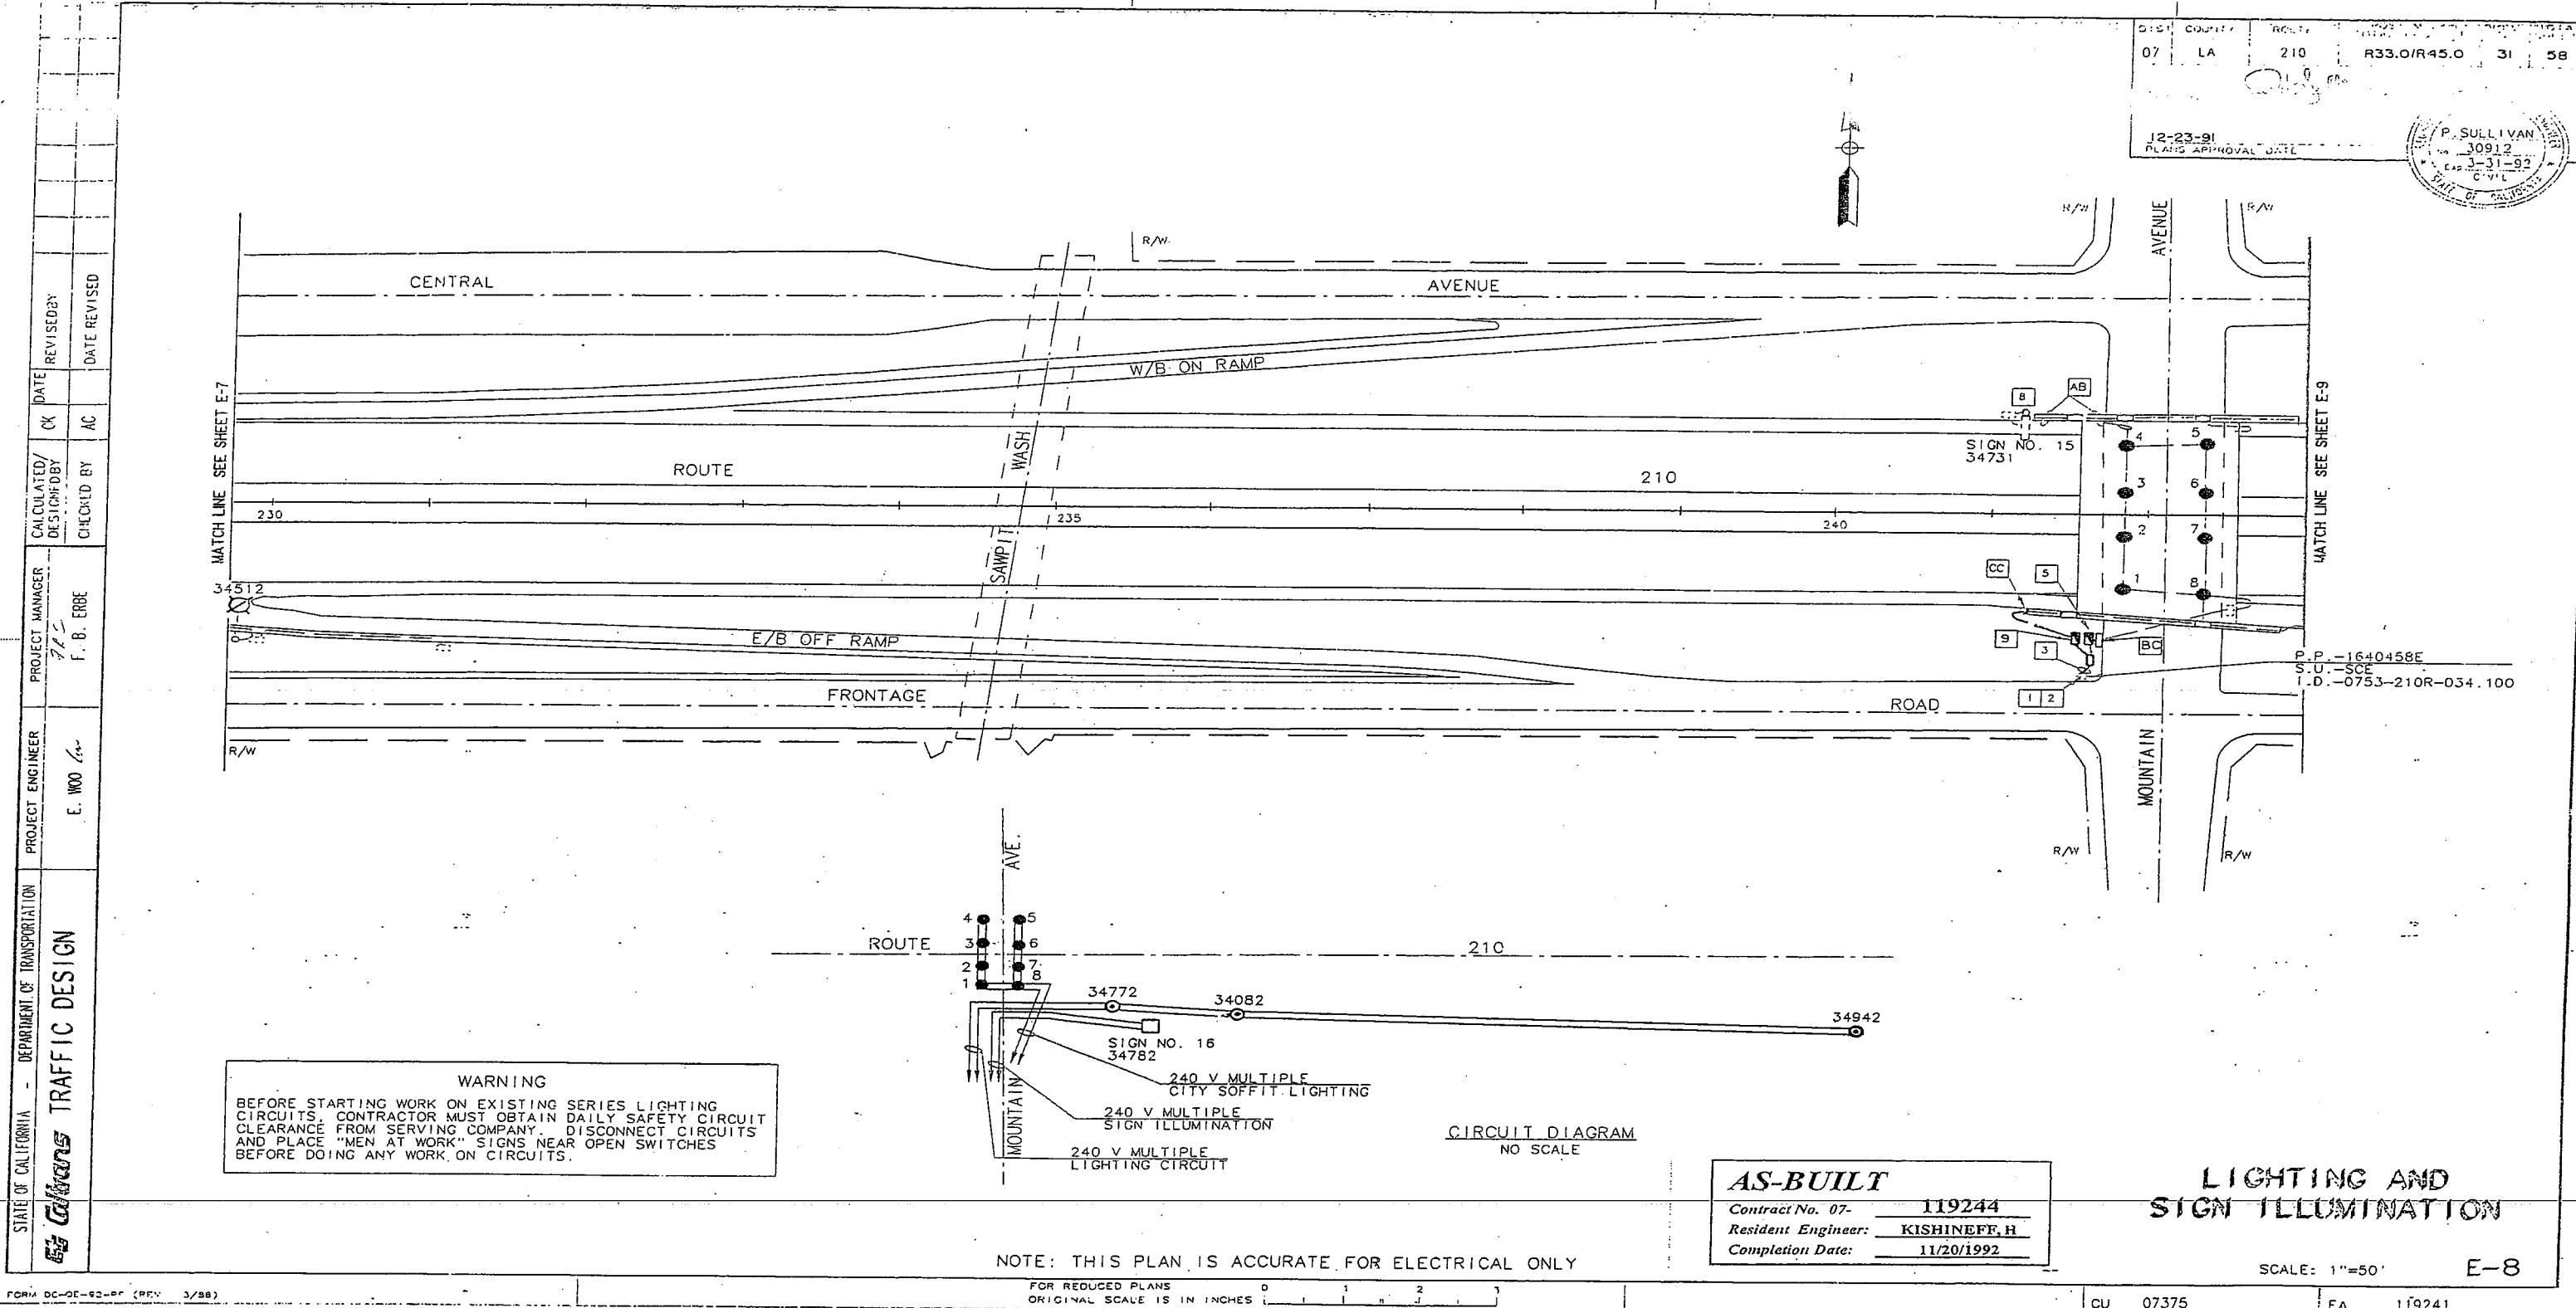

STATE OF CALIFORNIA - DEPARTMENT OF TRANSPORTATION	
TRAFFIC DESIGN	
Form DC-DE-92-PF (REV. 3/8A)	

CONDUCTOR SCHEDULE									
AWC	CIRCUIT	1	2	3	4	5	6	7	8
DLC	DEMAND LOOP DET.	—	—	—	—	2	2	—	—
	PASSAGE LOOP DET.	—	—	—	—	2	2	—	—
	QUEUE LOOP DET.	—	—	—	—	—	1	1	—
	SIGNAL	—	—	—	—	3	3	—	—
#14	METER-ON SPARE	—	—	—	—	—	2	2	—
#10	SIGNAL COMMON	—	—	—	—	—	1	2	1
#4	POWER SERVICE	—	—	—	—	—	—	—	2
#6	DEMAR. BOX SERVICE	—	—	—	—	—	—	—	—
#18	TELEPHONE CABLE	1	1	1	—	1	1	1	1
SHIELDED									
	CONDUIT SIZE	2"	2"	2"	2"	3"	3"	3"	2-3". 2"

CALCULATED BY AS 12/90 REV. 0 BY AP 12/90 DATE REV. SEC. 2/91

NOTES (THIS SHEET)

- 1 INSTALL STATE FURNISHED TYPE 170 CONTROLLER ASSEMBLY.
- 2 INSTALL TYPE "H" SERVICE RISER PER UTILITY COMPANY REQUIREMENTS.
- 3 INSTALL TELEPHONE BRIDGE IN EXISTING CONTROLLER CABINET.
- 4 INSTALL TYPE "A" DETECTOR HANHOLE.
- 5 INSTALL 120/240V. TYPE III-B METERED SERVICE EQUIPMENT ENCLOSURE WITH A 100A MAIN BREAKER AND A 40A I-P CIRCUIT BREAKER FOR RAMP METER CONTROLLER.

FOR PROJECT NOTES AND LEGEND SEE SHEET E-18.

NOTE: THIS PLAN ACCURATE FOR ELECTRICAL ONLY.



FORM DC-DE-92-PF (REV. 3/8A)

FOR REDUCED PLANS
ORIGINAL SCALE IS IN INCHES

0 1 2 3

DIST	COUNTY	ROUTE	POST MILLS	SECT	TOTAL LENGTH	NO. SPLS	TOTAL SPLS
			TOTAL PROJECT	NO. SPLS			
07	LA	210, 30	R25.0/R43.8	130	158	RO 3	

9-2-SJ
PLANS APPROVAL DATE

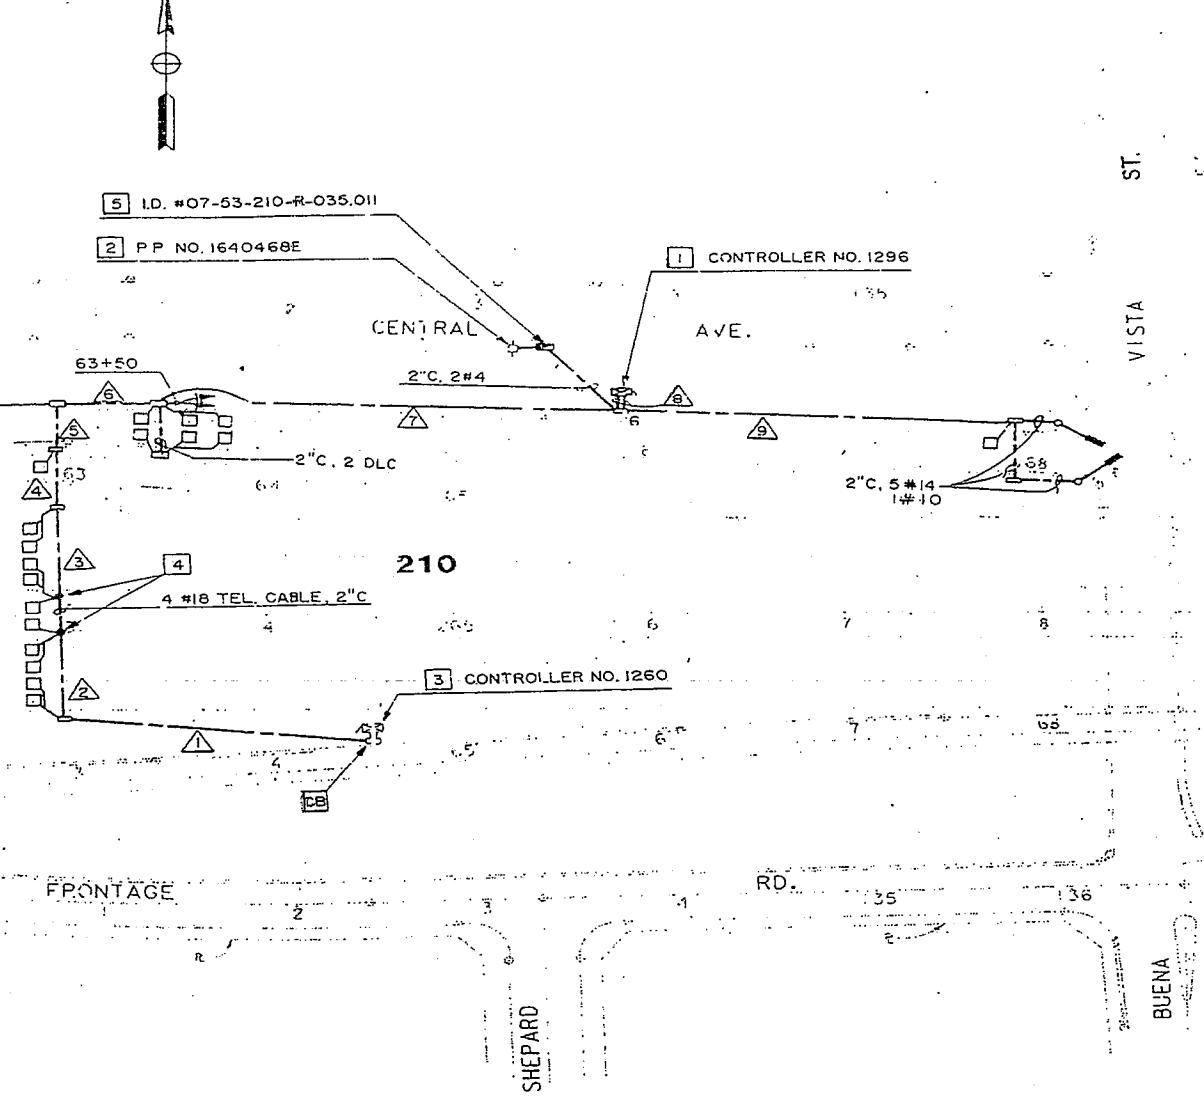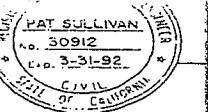

AS BUILT PLANS
Contract No. 07-069004
Date Completed 07-8-93
Document No.

AS BUILT
Contract No. 07-069004
Resident Engineer: Wayne V. Peirce
Completion Date: July 8, 1993
RAMP METERING SYSTEM
(LOCATION 2)

SCALE 1" = 50'

E-2

CU 07375 EA 069001

Land - 16

